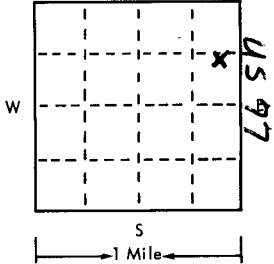
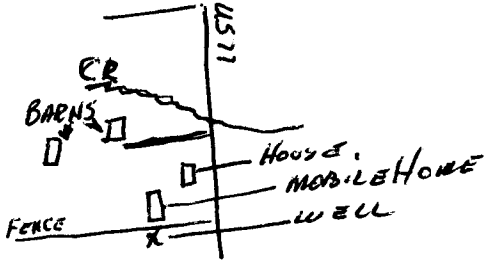


USE TYPEWRITER OR BALL POINT PEN-PRESS FIRMLY, PRINT CLEARLY.

WATER WELL RECORD
KSA 82a-1201-1215

T R EW sec 1/4 1/4 1/4 No.

Kansas State Dept. Of Health
(Water Well Contractors)
Forbes-Bldg. 740
Topeka, Kansas 66620

1 Location of well:	County Cowley	Township name Rock	Fraction NE 1/4	Section number 32	Town number 30	Range number 4 E	
Distance and direction from nearest town or city: 2 1/4 MI SOUTH ROCK WESTSIDE			3 Owner of well: J.C. BEAUNGARDT Address: RPD #1 ROCK KS				
Locate with "X" in section below: N 		Sketch map: NORTH ↑ 		4 Well depth: 115 ft. Date of completion 6/28/75 Well diameter 10 in.			
2 Type and color of material		From		To		5 <input checked="" type="checkbox"/> Cable tool <input type="checkbox"/> Rotary <input type="checkbox"/> Driven <input type="checkbox"/> Dug <input type="checkbox"/> Hollow rod <input type="checkbox"/> Jetted <input type="checkbox"/> Bored <input type="checkbox"/> Reverse rotary	
						6 Use: <input checked="" type="checkbox"/> Domestic <input type="checkbox"/> Public supply <input type="checkbox"/> Industry <input type="checkbox"/> Irrigation <input type="checkbox"/> Air conditioning <input type="checkbox"/> Commercial <input type="checkbox"/> Test well <input type="checkbox"/>	
SOIL + CLAY GRAVEL 0 5 LIME BROKEN WHITE MED 5 18 CAVEREN 18 22 LIME WHITE MED TO SOFT 22 45 SHALE BLUE 45 60 SHALE & LIME SHELLS 60 85 BLUE SHALE 85 115 VERY SMALL WATER APPROX. 40' WILL FILL HOLE OVERNIGHT CEMENT BASKET USED ON BOTTOM OF 30' STYRENE 6" 200 WALL CASING. CEMENT PLUG 30'-25' SAND FILLED CAVE NEAT GROUTED TO 0'-15' (use a second sheet if needed)						7 Casing: Material STYRENE Height: above 115 Threading: <input type="checkbox"/> Threaded <input type="checkbox"/> Welded <input type="checkbox"/> Surface 20 in. Diam. 200 WALL Weight _____ lbs./ft. _____ 6 in. to 30 ft. depth Drive shoe? <input type="checkbox"/> Yes <input type="checkbox"/> No _____ in. to _____ ft. depth	
						8 Screen: NONE - OPEN HOLE COMPLETION Manufacturer _____ Type _____ Dia. _____ Slot/gauze _____ Length _____ Set between _____ ft. and _____ ft. _____ Fittings: _____ Gravel pack <input type="checkbox"/> Yes <input type="checkbox"/> No Size range of material _____	
						9 Static water level: 42 ft. below land surface Date 6/30/75	
						10 Pumping level below land surfaces: _____ ft. after _____ hrs. pumping _____ g.p.m. _____ ft. after _____ hrs. pumping _____ g.p.m. Estimated maximum yield 1/2 g.p.m.	
						11 Water sample submitted: <input type="checkbox"/> Yes <input checked="" type="checkbox"/> No Date _____	
						12 Well head completion: <input type="checkbox"/> Pitless adapter 24 inches above grade	
						13 Well grouted? <input checked="" type="checkbox"/> Yes <input type="checkbox"/> No <input checked="" type="checkbox"/> Neat cement <input type="checkbox"/> Bentonite <input type="checkbox"/> Depth: From 90 ft. to SURFACE	
						14 Nearest source of possible contamination: MOBILE HOME ft. 600 Direction EAST Type _____ Well disinfected upon completion? <input checked="" type="checkbox"/> Yes <input type="checkbox"/> No	
						15 Pump: <input checked="" type="checkbox"/> Not installed Manufacturer's name _____ Model number _____ HP _____ Volts _____ Length of drop pipe _____ ft. capacity _____ g.p.m. Type: <input type="checkbox"/> Submersible <input type="checkbox"/> Turbine <input type="checkbox"/> Jet <input type="checkbox"/> Reciprocating <input type="checkbox"/> Centrifugal <input type="checkbox"/> Other	
						16 Remarks: elevation OWNER TO CONSTRUCT SLAB AND WELL HOUSE @ LATER DATE	
Topography: <input type="checkbox"/> Hill <input checked="" type="checkbox"/> Slope <input type="checkbox"/> Upland <input type="checkbox"/> Valley							

Forward the white, blue and pink copies to the Kansas State Dept. Of Health.

Form WWC-5