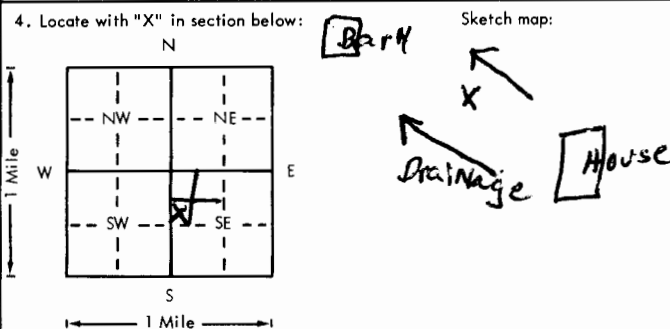


USE TYPEWRITER OR BALL POINT PEN-PRESS FIRMLY, PRINT CLEARLY.

WATER WELL RECORD
KSA 82a-1201-1215

Kansas Department of Health and Environment
Division of Environment
(Water well Contractors)
Topeka, Kansas 66620

1. Location of well: County <u>Cowley</u> Fraction <u>SW 1/4 NW 1/4 SE 1/4</u> Section number <u>25</u> Township number <u>T 30 S R 5 E</u> Range number <u>5</u>	
2. Distance and direction from nearest town or city: <u>7 50 2 1/4 E of Smileyville</u>	
3. Owner of well: <u>Harold Behrendt</u> R.R. or street: <u>7610 S MCINTOSH RD</u> City, state, zip code: <u>Derby KS 67037</u>	
4. Locate with "X" in section below:  Sketch map: <u>Barry</u> <u>House</u>	
5. Type and color of material	
6. Bore hole dia. <u>8.5</u> in. Completion date <u>10-27-78</u> Well depth <u>90</u> ft.	
7. <input checked="" type="checkbox"/> Cable tool <input type="checkbox"/> Rotary <input type="checkbox"/> Driven <input type="checkbox"/> Dug <input type="checkbox"/> Hollow rod <input type="checkbox"/> Jetted <input type="checkbox"/> Bored <input type="checkbox"/> Reverse rotary	
8. Use: <input checked="" type="checkbox"/> Domestic <input type="checkbox"/> Public supply <input type="checkbox"/> Industry <input type="checkbox"/> Irrigation <input type="checkbox"/> Air conditioning <input type="checkbox"/> Stock <input type="checkbox"/> Lawn <input type="checkbox"/> Oil field water <input type="checkbox"/> Other	
9. Casing: Material <u>PITS</u> Height: Above or below Threaded <input type="checkbox"/> Welded <u>glue</u> surface <u>20</u> in. RMP <input checked="" type="checkbox"/> PVC <input type="checkbox"/> Weight _____ lbs./ft. Dia. <u>5</u> in. to <u>90</u> ft. depth Wall Thickness: inches or Dia. _____ in. to _____ ft. depth gage No. <u>200</u>	
10. Screens: Manufacturer's name <u>SUNFLOWER</u> <u>MEG ING</u> Type <u>RMP</u> Dio. <u>5"</u> Slot/gauze <u>1/16</u> Length <u>10 FT</u> Set between <u>80</u> ft. and <u>90</u> ft. _____ ft. and _____ ft. Grovel pack? <u>NO</u> Size range of material _____	
11. Static water level: _____ mo./day/yr. <u>20</u> ft. below land surface Date <u>10-27-78</u>	
12. Pumping level below land surfaces: <u>NA</u> _____ ft. after _____ hrs. pumping _____ g.p.m. _____ ft. after _____ hrs. pumping _____ g.p.m. Estimated maximum yield _____ g.p.m.	
13. Water sample submitted: _____ mo./day/yr. <input type="checkbox"/> Yes <input checked="" type="checkbox"/> No Date _____	
14. Well head completion: <input checked="" type="checkbox"/> Pitless adapter <u>20</u> inches above grade	
15. Well grouted? <u>yes</u> With: <input type="checkbox"/> Neat cement <input type="checkbox"/> Bentonite <input checked="" type="checkbox"/> Concrete Depth: From <u>13</u> ft. to <u>3</u> ft.	
16. Nearest source of possible contamination: ft. <u>20</u> Direction <u>NW</u> Type <u>Barry</u> Well disinfected upon completion? <input checked="" type="checkbox"/> Yes <input type="checkbox"/> No	
17. Pump: <input checked="" type="checkbox"/> Not installed Manufacturer's name _____ Model number _____ HP _____ Volts _____ Length of drop pipe _____ ft. capacity _____ g.p.m. Type: <input type="checkbox"/> Submersible <input type="checkbox"/> Turbine <input type="checkbox"/> Jet <input type="checkbox"/> Reciprocating <input type="checkbox"/> Centrifugal <input type="checkbox"/> Other	
(Use a second sheet if needed)	
18. Elevation: Topography: <input type="checkbox"/> Hill <input checked="" type="checkbox"/> Slope <input type="checkbox"/> Upland <input type="checkbox"/> Valley	19. Remarks: <u>owner will install concrete slab</u>
20. Water well contractor's certification: This well was drilled under my jurisdiction and this report is true to the best of my knowledge and belief. <u>Braddy water wells 363</u> Business name _____ License No. _____ Address <u>R2 Box 217A Derby KS 67037</u> Signed <u>Richard Braddy</u> Date <u>10-27-78</u> Authorized representative	

T 30 S R 5 E Sec 25 SW 1/4 SE

Forward the white, blue and pink copies to the Department of Health and Environment

Form WWC-5