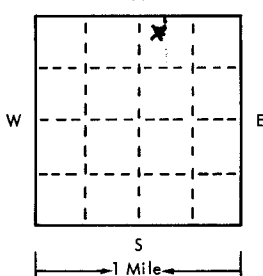
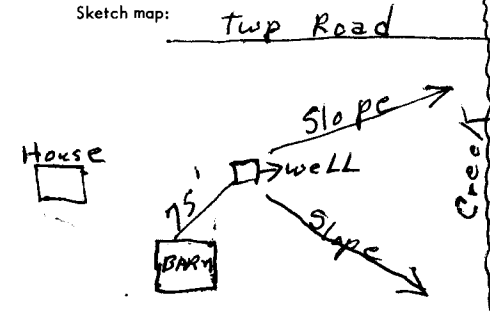


USE TYPEWRITER OR BALL POINT PEN-PRESS FIRMLY, PRINT CLEARLY.

WATER WELL RECORD
KSA 82a-1201-1215

T R EW sec 1/4 1/4 1/4 No.

Kansas State Dept. Of Health
(Water Well Contractors)
Forbes-Bldg. 740
Topeka, Kansas 66620

1 Location of well:	County Cowley	Township name Rich Land	Fraction nw-nw-ne	Section number 33	Town number 30	Range number 5
Distance and direction from nearest town or city: 2 miles north of W. Lmat + 1/2 mile west, South side of Road Street address of well location if in city:				3 Owner of well: WALTER Meyen Address: Route 1 Rock, Kansas 67131		
Locate with "X" in section below: N 		Sketch map: 		4 Well depth: 80 ft. Date of completion 11-20-76 Well diameter 10 in.		
2 Type and color of material		From		To		5 <input checked="" type="checkbox"/> Cable tool <input type="checkbox"/> Rotary <input type="checkbox"/> Driven <input type="checkbox"/> Dug <input type="checkbox"/> Hollow rod <input type="checkbox"/> Jetted <input type="checkbox"/> Bored <input type="checkbox"/> Reverse rotary
						6 Use: <input checked="" type="checkbox"/> Domestic <input type="checkbox"/> Public supply <input type="checkbox"/> Industry <input type="checkbox"/> Irrigation <input type="checkbox"/> Air conditioning <input type="checkbox"/> Commercial <input type="checkbox"/> Test well
Top Soil		0		2		7 Casing: Material Plastic Height: above/below <input checked="" type="checkbox"/> Threaded <input type="checkbox"/> Welded <input type="checkbox"/> Surface 4 FT in. Diam. _____ Weight 200 lbs./ft. 6 in. to 80 ft. depth Drive shoe? <input type="checkbox"/> Yes <input type="checkbox"/> No _____ in. to _____ ft. depth
Red Clay		2		12		8 Screen: Casing Perforated Bottom 10 FT Manufacturer _____ Type _____ Dia. _____ Slot/gauze _____ Length _____ Set between 13 ft. and 80 ft. Fittings: Gravel pack <input checked="" type="checkbox"/> Yes <input type="checkbox"/> No Size range of material 5/8"
Clay Gravel		12		14		9 Static water level: 13 ft. below land surface Date 11-20-76
Lime		14		40		10 Pumping level below land surfaces: Bailer test _____ ft. after _____ hrs. pumping _____ g.p.m. _____ ft. after _____ hrs. pumping _____ g.p.m. Estimated maximum yield 8 g.p.m.
Blue Shale		40		50		11 Water sample submitted: <input type="checkbox"/> Yes <input checked="" type="checkbox"/> No Date _____
Lime		50		65		12 Well head completion: <input checked="" type="checkbox"/> Pitless adapter <input checked="" type="checkbox"/> 48" inches above grade
Blue Shale		65		80		13 Well grouted? <input checked="" type="checkbox"/> Yes <input type="checkbox"/> No <input checked="" type="checkbox"/> Neat cement <input type="checkbox"/> Bentonite <input type="checkbox"/> _____ Depth: From 2 ft. to 12 ft.
Water vein at 58 Ft.						14 Nearest source of possible contamination: ft. 75 Direction SW Type Barn Well disinfected upon completion? <input checked="" type="checkbox"/> Yes <input type="checkbox"/> No
						15 Pump: <input checked="" type="checkbox"/> Not installed Manufacturer's name _____ Model number _____ HP _____ Volts _____ Length of drop pipe _____ ft. capacity _____ g.m.p. Type: <input type="checkbox"/> Submersible <input type="checkbox"/> Turbine <input type="checkbox"/> Jet <input type="checkbox"/> Reciprocating <input type="checkbox"/> Centrifugal <input type="checkbox"/> Other
16 Remarks: elevation Bare lot						17 Water well contractor's certification: This well was drilled under my jurisdiction and this report is true to the best of my knowledge and belief. Ronal HEFFRON Drilling #113 Business name _____ License No. _____ Address Route 3 Sunfield, Kans Signed Ronal Heffron Date 12-10-76 Authorized representative

30 SW 33 NW NW NE