

USE TYPEWRITER OR BALL
POINT PEN-PRESS FIRMLY,
PRINT CLEARLY.

WATER WELL RECORD
KSA 82a-1201-1215


T R EW sec 1/4 1/4 1/4 No.

Kansas State Dept. Of Health
(Water Well Contractors)
Forbes-Bldg. 740
Topeka, Kansas 66620

NWSW NW

1 Location of well:	County Cowley	Township name Omnia	Fraction SW 1/4 SE 1/4 SE 1/4	Section number 15	Town number T 30 S	Range number R 6 E
---------------------	-------------------------	-------------------------------	---	-----------------------------	------------------------------	------------------------------

Distance and direction from nearest town or city: 1/4 mile East of Atlanta	3 Owner of well: Aubrey Snodgrass
Street address of well location if in city:	Address: Atlanta, Kansas

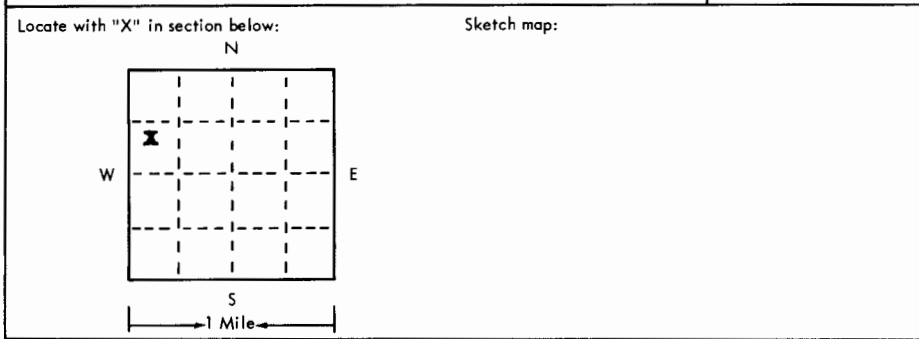

4 Well depth: 130 ft. Date of completion 4-29-75
Well diameter 9 in.

5 Cable tool Rotary Driven Dug
 Hollow rod Jetted Bored Reverse rotary

6 Use: Domestic Public supply Industry
 Irrigation Air conditioning Commercial
 Test well

7 Casing: Material styrine: above below
Threaded RMP Welded Surface 12 in.
Diam. 130 Weight 128 lbs./ft. 100
5 in. to 100 depth! Drive shoe? Yes No
 in. to ft. depth!

2	Type and color of material	From	To
	Old well that caved in. Cleaned mud out and cased. Installed pump and sanitary well seal. Also sanitized.		
	Did not do any more drilling and a drilling report would be impossible.		
	(use a second sheet if needed)		

8 Screen:
Manufacturer Perforated styrene
Type RMP Dia. 3 5 in.
5 in. gauze 1/8 Length 40'
Set between 130 ft. and 90 ft.
Fittings:
Gravel pack Yes No Size range of material

9 Static water level:
25 ft. below land surface Date 4-29-75

10 Pumping level below land surfaces:
 ft. after hrs. pumping g.p.m.
 ft. after hrs. pumping g.p.m.
Estimated maximum yield g.p.m.

11 Water sample submitted:
 Yes No Date

12 Well head completion:
 Pitless adapter 12 inches above grade

13 Well grouted? Yes No
 Neat cement Bentonite
Depth: From 80 ft. to 20 ft.

14 Nearest source of possible contamination:
ft. 55 Direction North Type Cattle
Well disinfected upon completion? Yes No

15 Pump:
 Not installed
Manufacturer's name Redia
Model number NA HP 1/3 Volts 115
Length of drop pipe 90 ft. capacity NA g.m.p.
Type:
 Submersible Turbine
 Jet Reciprocating
 Centrifugal Other

16 Remarks: elevation

Topography:
 Hill
 Slope
 Upland
 Valley

17 Water well contractor's certification:
This well was drilled under my jurisdiction and this report is true to the best of my knowledge and belief.

Eastman Drilling 779
Business name Eastman Drilling 779 License No.
Address 1809 E 12th Wichita Kansas
Signed Del Eastman Date 4-29-75
Authorized representative