


MW-6 2011072

1 LOCATION OF WATER WELL: County: <u>SUMNER</u>	Fraction <u>NW 1/4 NE 1/4 NE 1/4</u>	Section Number <u>2</u>	Township Number T <u>3031</u> S	Range Number R <u>1</u> <u>EW</u>
--	---	----------------------------	------------------------------------	--------------------------------------

Distance and direction from nearest town or city street address of well if located within city?
312 N. MERCHANT ST., BELLE PLAINE, KS

2 WATER WELL OWNER: GAYLE HABLITZEL
 RR#, St. Address, Box #: 915 NORTH SUMNER
 City, State, ZIP Code: BELLE PLAINE, KS 67013

Board of Agriculture, Division of Water Resources
 Application Number:

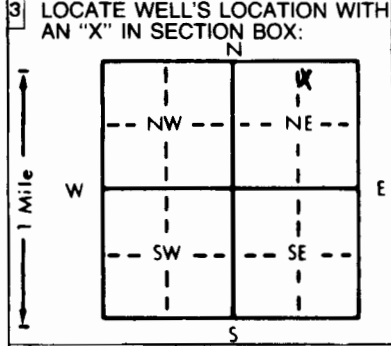

4 DEPTH OF COMPLETED WELL: 28.0 ft. ELEVATION: _____ ft.

Depth(s) Groundwater Encountered 1. 23.5 ft. 2. _____ ft. 3. _____ ft.

WELL'S STATIC WATER LEVEL 25.10 ft. below land surface measured on mo/day/yr 8/7/95

Pump test data: Well water was _____ ft. after _____ hours pumping _____ gpm

Est. Yield _____ gpm: Well water was _____ ft. after _____ hours pumping _____ gpm

Bore Hole Diameter: 8 in. to _____ ft., and _____ in. to _____ ft.

WELL WATER TO BE USED AS:

5 Public water supply	8 Air conditioning	11 Injection well
1 Domestic	3 Feedlot	6 Oil field water supply
2 Irrigation	4 Industrial	7 Lawn and garden only
		9 Dewatering
		10 <u>Monitoring well</u>
		12 Other (Specify below)

Was a chemical/bacteriological sample submitted to Department? Yes _____ No X; If yes, mo/day/yr sample was submitted _____

Water Well Disinfected? Yes _____ No X

5 TYPE OF BLANK CASING USED:

1 Steel	3 RMP (SR)	5 Wrought iron	8 Concrete tile	CASING JOINTS: Glued _____ Clamped _____
<u>2 PVC</u>	4 ABS	6 Asbestos-Cement	9 Other (specify below)	Welded _____
Blank casing diameter: <u>2</u> in. to _____ ft., Dia _____ in. to _____ ft., Dia _____ in. to _____ ft.		7 Fiberglass		<u>Threaded</u> <u>FLUSH</u>
Casing height above land surface: <u>FLUSH</u> in., weight _____ lbs./ft. Wall thickness or gauge No. <u>154</u>				

TYPE OF SCREEN OR PERFORATION MATERIAL:

1 Steel	3 Stainless steel	5 Fiberglass	8 RMP (SR)	10 Asbestos-cement
2 Brass	4 Galvanized steel	6 Concrete tile	9 ABS	11 Other (specify)
SCREEN OR PERFORATION OPENINGS ARE:		5 Gauzed wrapped	8 Saw cut	11 None (open hole)
1 Continuous slot	<u>3 Mill slot</u>	6 Wire wrapped	9 Drilled holes	
2 Louvered shutter	4 Key punched	7 Torch cut	10 Other (specify)	

SCREEN-PERFORATED INTERVALS: From 18 ft. to 28 ft., From _____ ft. to _____ ft.

GRAVEL PACK INTERVALS: From 16 ft. to 28 ft., From _____ ft. to _____ ft.

6 GROUT MATERIAL: 1 Neat cement 2 Cement grout 3 Bentonite 4 Other _____

Grout Intervals: From 16 ft. to 2 ft., From _____ ft. to _____ ft., From _____ ft. to _____ ft.

What is the nearest source of possible contamination:

1 Septic tank	4 Lateral lines	7 Pit privy	10 Livestock pens	14 Abandoned water well
2 Sewer lines	5 Cess pool	8 Sewage lagoon	<u>11 Fuel storage</u>	15 Oil well/Gas well
3 Watertight sewer lines	6 Seepage pit	9 Feedyard	12 Fertilizer storage	16 Other (specify below)
			13 Insecticide storage	

Direction from well? NORTH EAST How many feet? 400

FROM	TO	LITHOLOGIC LOG	FROM	TO	PLUGGING INTERVALS
0	2.0	SILT, CLAYEY			
2.0	11.0	CLAY, SILTY			
11.0	18.0	SAND			
18.0	23.5	SAND, LITTE GRAVEL, SILTY			
23.5	28.0	SAND, GRAVEL			

7 CONTRACTOR'S OR LANDOWNER'S CERTIFICATION: This water well was (1) constructed, (2) reconstructed, or (3) plugged under my jurisdiction and was completed on (mo/day/year) 8/7/95 and this record is true to the best of my knowledge and belief. Kansas Water Well Contractor's License No. 531 This Water Well Record was completed on (mo/day/yr) 8/16/95 under the business name of GSI by (signature) Steve Needle