


1 LOCATION OF WATER WELL: County: SUMNER Fraction: NW 1/4 NE 1/4 NE 1/4 Section Number: 2 Township Number: T 3031 S Range Number: R 1 EW

Distance and direction from nearest town or city street address of well if located within city?
319 N. MAIN, BELLE PLAINE, KS

2 WATER WELL OWNER: GAYLE HABLITZEL
 RR#, St. Address, Box #: 915 NORTH SUMNER
 City, State, ZIP Code: BELLE PLAINE, KS 67013
 Board of Agriculture, Division of Water Resources
 Application Number:

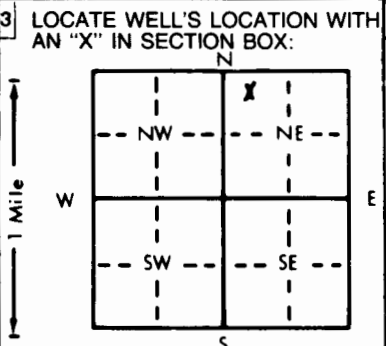

4 DEPTH OF COMPLETED WELL: 28.0 ft. ELEVATION: ft.
 Depth(s) Groundwater Encountered 1. 22.7 ft. 2. ft. 3. ft.
 WELL'S STATIC WATER LEVEL 22.67 ft. below land surface measured on mo/day/yr 8/7/95
 Pump test data: Well water was ft. after hours pumping gpm
 Est. Yield gpm; Well water was ft. after hours pumping gpm
 Bore Hole Diameter: 8 in. to ft., and in. to ft.
 WELL WATER TO BE USED AS:
 5 Public water supply 8 Air conditioning 11 Injection well
 1 Domestic 3 Feedlot 6 Oil field water supply 9 Dewatering 12 Other (Specify below)
 2 Irrigation 4 Industrial 7 Lawn and garden only 10 Monitoring well
 Was a chemical/bacteriological sample submitted to Department? Yes..... No X.....; If yes, mo/day/yr sample was submitted
 Water Well Disinfected? Yes No X

5 TYPE OF BLANK CASING USED:
 1 Steel 3 RMP (SR) 5 Wrought iron 8 Concrete tile CASING JOINTS: Glued Clamped
2 PVC 4 ABS 6 Asbestos-Cement 9 Other (specify below) Welded
 Blank casing diameter 2 in. to ft., Dia. in. to ft., Dia. in. to ft.
 Casing height above land surface: FLUSH in., weight 703 lbs./ft. Wall thickness or gauge No. 154
 TYPE OF SCREEN OR PERFORATION MATERIAL:
 1 Steel 3 Stainless steel 5 Fiberglass 7 PVC 10 Asbestos-cement
 2 Brass 4 Galvanized steel 6 Concrete tile 9 ABS 11 Other (specify)
 12 None used (open hole)
 SCREEN OR PERFORATION OPENINGS ARE:
 1 Continuous slot 3 Mill slot 5 Gauzed wrapped 8 Saw cut 11 None (open hole)
 2 Louvered shutter 4 Key punched 6 Wire wrapped 9 Drilled holes
 7 Torch cut 10 Other (specify)
 SCREEN-PERFORATED INTERVALS: From 18 ft. to 28 ft., From ft. to ft.
 From ft. to ft., From ft. to ft.
 GRAVEL PACK INTERVALS: From 16 ft. to 28 ft., From ft. to ft.
 From ft. to ft., From ft. to ft.

6 GROUT MATERIAL:
 1 Neat cement 2 Cement grout 3 Bentonite 4 Other
 Grout Intervals: From 16 ft. to 1.5 ft., From ft. to ft., From ft. to ft.
 What is the nearest source of possible contamination:
 1 Septic tank 4 Lateral lines 7 Pit privy 11 Fuel storage 14 Abandoned water well
 2 Sewer lines 5 Cess pool 8 Sewage lagoon 12 Fertilizer storage 15 Oil well/Gas well
 3 Watertight sewer lines 6 Seepage pit 9 Feedyard 13 Insecticide storage 16 Other (specify below)

Direction from well? NORTH NORTHWEST How many feet? 150 200

FROM	TO	LITHOLOGIC LOG	FROM	TO	PLUGGING INTERVALS
0	1.0	SAND, VERY SILTY, VERY CLAYEY			
1.0	4.0	CLAY, VERY SILTY			
4.0	8.0	CLAY, VERY SILTY			
8.0	17.0	SAND, SILTY			
17.0	26.5	SAND, GRAVEL			
26.5	28.0	CLAY			

7 CONTRACTOR'S OR LANDOWNER'S CERTIFICATION: This water well was (1) constructed, (2) reconstructed, or (3) plugged under my jurisdiction and was completed on (mo/day/year) 8/7/95 and this record is true to the best of my knowledge and belief. Kansas Water Well Contractor's License No. 531 This Water Well Record was completed on (mo/day/yr) 8/16/95 under the business name of GSI by (signature) Steve Nudler