


1 LOCATION OF WATER WELL: Sumner	Fraction SW $\frac{1}{4}$ NW $\frac{1}{4}$ SE $\frac{1}{4}$	Section Number 9	Township Number 31S	Range Number 1
---	--	----------------------------	-------------------------------	--------------------------

Distance and direction from nearest town or city street address of well if located within city?
Mile marker #25, Kansas Turnpike, Belle Plaine, Kansas

2 WATER WELL OWNER: **Kansas Turnpike Authority**

RR #, St. Address, Box #: **9401 E. Kellogg** Board of Agriculture, Division of Water Resources
 City, State, ZIP Code: **Wichita, Ks 67207** Application Number:

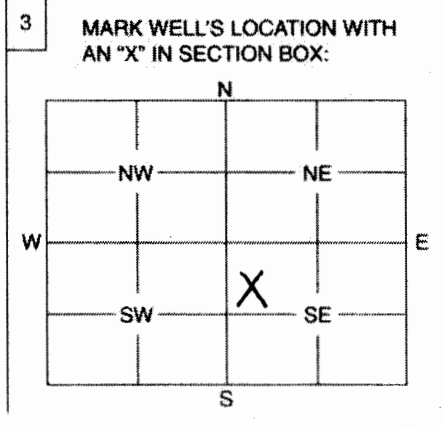

4 DEPTH OF WELL 16.2 ft.
 WELL'S STATIC WATER LEVEL 13.98 ft.

WELL WAS USED AS:

1 Domestic	5 Public Water Supply	9 Dewatering
2 Irrigation	6 Oil Field Water Supply	<input checked="" type="checkbox"/> 10 Monitoring Well
3 Feedlot	7 Domestic (Lawn & Garden)	11 Injection Well
4 Industrial	8 Air Conditioning	12 Other

Was a chemical / bacteriological sample submitted to Department? Yes No

If yes, mo/day/yr sample was submitted

Water Well Disinfected: Yes No

5 TYPE OF BLANK CASING USED:

<input checked="" type="checkbox"/> 1 Steel	<input type="checkbox"/> 3 RMP (SR)	<input type="checkbox"/> 5 Wrought	<input type="checkbox"/> 7 Fiberglass	<input type="checkbox"/> 9 Other (Specify below)
<input checked="" type="checkbox"/> 2 PVC	<input type="checkbox"/> 4 ABS	<input type="checkbox"/> 6 Asbestos-Cement	<input type="checkbox"/> 8 Concrete Tile	

Blank casing diameter 2 in. Was casing pulled? Yes No If yes, how much 10 in.

6 GROUT PLUG MATERIAL: 1 Neat cement 2 Cement grout 3 Bentonite 4 Other

Grout Plug Intervals: From 3 16.2 ft. to 0 ft., From ft. to ft., From to ft.

What is the nearest source of possible contamination:

1 Septic tank	6 Seepage pit	11 Fuel storage	<input checked="" type="checkbox"/> 16 Other (specify below)
2 Sewer lines	7 Pit privy	12 Fertilizer storage	<u>cont. site</u>
3 Watertight sewer lines	8 Sewage lagoon	13 Insecticide storage	
4 Lateral lines	9 Feedyard	14 Abandoned water well	
5 Cess pool	10 Livestock pens	15 Oil well/Gas well	

Direction from well? How many feet?

FROM	TO	PLUGGING MATERIALS
16.2	0	Bentonite

flush mount well/pad was left in place, will be removed during construction

7 CONTRACTOR'S OF LANDOWNER'S CERTIFICATION: This water well was plugged under my jurisdiction and was completed on (mo/day/year) 1-2-08 and this record is true to the best of my knowledge and belief. Kansas Water Well Contractor's License No. 585 This Water Well Record was completed on (mo/day/year) 02/01/08 under the business name of Associated Environmental, Inc by (signature) B. Johnson

INSTRUCTIONS: Use typewriter or ball point pen. Please press firmly and print clearly. Please fill in blanks, underline or circle the correct answers. Send top three copies to Kansas Department of Health and Environment, Bureau of Water, Geology Section, 1000 SW Jackson St., Ste. 420, Topeka, Kansas 66612-1367. Telephone: 785/296-5522. Send one to Water Well Owner and retain one for your records.