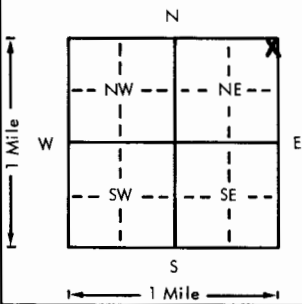


USE TYPEWRITER OR BALL POINT PEN-PRESS FIRMLY, PRINT CLEARLY.

WATER WELL RECORD
KSA 82a-1201-1215

Kansas Department of Health and Environment
Division of Environment
(Water well Contractors)
Topeka, Kansas 66620

1. Location of well:	County Sumner	Fraction 1/4 NE 1/4 NE 1/4	Section number 8	Township number T 31 S R 1E	Range number E/W
2. Distance and direction from nearest town or city: Street address of well location if in city: 1 West of Belle Plaine Y, 1 South, 1/2 East on			3. Owner of well: Bryan Sears R.R. or street: R#2 City, state, zip code: Belle Plaine, Kansas		
4. Locate with "X" in section below: Sketch map: the south side of the road. Belle Plaine, Kansas			6. Bore hole dia. <u>11</u> in. Completion date _____ Well depth <u>75</u> ft. <u>10-10-77</u>		
			7. <input checked="" type="checkbox"/> Cable tool <input checked="" type="checkbox"/> Rotary <input type="checkbox"/> Driven <input type="checkbox"/> Dug <input type="checkbox"/> Hollow rod <input type="checkbox"/> Jetted <input type="checkbox"/> Bored <input type="checkbox"/> Reverse rotary		
			8. Use: <input checked="" type="checkbox"/> Domestic <input type="checkbox"/> Public supply <input type="checkbox"/> Industry <input type="checkbox"/> Irrigation <input type="checkbox"/> Air conditioning <input type="checkbox"/> Stock <input type="checkbox"/> Lawn <input type="checkbox"/> Oil field water <input type="checkbox"/> Other		
5. Type and color of material			9. Casing: Material <u>styrene</u> Weight: Above or below _____ Threaded _____ Welded <u>gl</u> Surface <u>12</u> in. RMP <input checked="" type="checkbox"/> PVC _____ Weight _____ lbs./ft. Dia. <u>5</u> in. to <u>75</u> ft. depth; Wall Thickness: inches or _____ Dia. _____ in. to _____ ft. depth; gage No. <u>.200</u>		
			10. Screen: Manufacturer's name _____ Sunflower Plastic Type <u>styrene</u> Dia. <u>5"</u> Slot/gauge <u>.06</u> Length <u>55"</u> Set between <u>20</u> ft. and <u>75</u> ft. ft. and _____ ft. Gravel pack? <input checked="" type="checkbox"/> yes _____ Size range of material <u>1/4-1/8"</u>		
Topsoil			11. Static water level: _____ mo./day/yr. <u>15</u> ft. below land surface Date <u>10-10-77</u>		
Clay			12. Pumping level below land surfaces: _____ ft. after _____ hrs. pumping _____ g.p.m. _____ ft. after _____ hrs. pumping _____ g.p.m. Estimated maximum yield _____ g.p.m.		
Fine Sand			13. Water sample submitted: _____ mo./day/yr. Yes _____ No _____ Date _____		
Shale			14. Well head completion: _____ <input checked="" type="checkbox"/> Pitless adapter <u>12</u> capped _____ inches above grade		
			15. Well grouted? <input checked="" type="checkbox"/> yes <u>1-2 fine sand mix</u> With: _____ Neat cement _____ Bentonite <input checked="" type="checkbox"/> Concrete _____ Depth: From <u>40"</u> ft. to <u>14</u> ft.		
			16. Nearest source of possible contamination: <u>NONE</u> ft. _____ Direction _____ Type _____ Well disinfected upon completion? <input checked="" type="checkbox"/> Yes _____ No		
			17. Pump: _____ Not installed Manufacturer's name _____ Model number _____ HP _____ Volts _____ Length of drop pipe _____ ft. capacity _____ g.p.m. Type: <input type="checkbox"/> Submersible _____ Turbine _____ <input type="checkbox"/> Jet _____ Reciprocating _____ <input type="checkbox"/> Centrifugal _____ Other _____		
(Use a second sheet if needed)					
18. Elevation:		19. Remarks: Flat Ground Septic system not installed at this time. No apparent source for contamination.		20. Water well contractor's certification: This well was drilled under my jurisdiction and this report is true to the best of my knowledge and belief. Harp Well & Pump 236 Business name Wichita, Kansas License No. _____ Address _____ Signed <u>M. Arnold</u> Date <u>10-11-77</u> Authorized representative	

T 31 S R 1E
 Sec 8
 1/4 1/4 1/4 1/4
 NENE