


1 LOCATION OF WATER WELL: Fraction NE 1/4 NE 1/4 NW 1/4 Section Number 11 Township Number T 31 S Range Number R 10 E  
 County: SUMNER

Distance and direction from nearest town or city street address of well if located within city:  
1 1/2 W. Belle Plain Rds.

2 WATER WELL OWNER: Tornado Drilling  
 RR#, St. Address, Box #: BY 37  
 City, State, ZIP Code: CANTON KS 67428  
 Board of Agriculture, Division of Water Resources  
 Application Number:

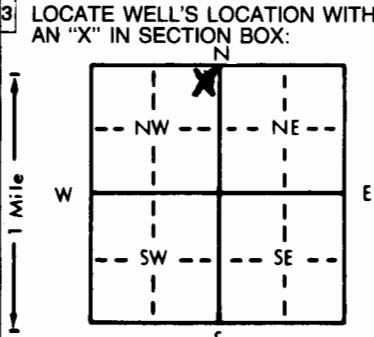

4 DEPTH OF COMPLETED WELL: 42 ft. ELEVATION:  
 Depth(s) Groundwater Encountered 1. 14 ft. 2. 14 ft. 3. 14 ft.  
 WELL'S STATIC WATER LEVEL: 14 ft. below land surface measured on mo/day/yr 12-18-89  
 Pump test data: Well water was 14 ft. after 1/2 hours pumping 20 gpm  
 Est. Yield 100 gpm: Well water was 14 ft. after 1/2 hours pumping 20 gpm  
 Bore Hole Diameter: 11 in. to 50 ft., and 50 in. to 50 ft.  
 WELL WATER TO BE USED AS:  
 5 Public water supply 8 Air conditioning 11 Injection well  
 1 Domestic 3 Feedlot 6 Oil field water supply 9 Dewatering 12 Other (Specify below)  
 2 Irrigation 4 Industrial 7 Lawn and garden only 10 Monitoring well  
 Was a chemical/bacteriological sample submitted to Department? Yes X No X If yes, mo/day/yr sample was submitted  
 Water Well Disinfected? Yes X No X

5 TYPE OF BLANK CASING USED:  
 1 Steel 3 RMP (SR) 5 Wrought iron 8 Concrete tile CASING JOINTS: Glued X Clamped  
 2 PVC 4 ABS 6 Asbestos-Cement 9 Other (specify below) Welded  
 7 Fiberglass Threaded  
 Blank casing diameter: 5 in. to 24 ft. Dia. 500-26 lbs./ft. Wall thickness or gauge No. 500-26  
 Casing height above land surface: 12 in., weight 1.59  
 TYPE OF SCREEN OR PERFORATION MATERIAL:  
 1 Steel 3 Stainless steel 5 Fiberglass 8 RMP (SR) 10 Asbestos-cement 11 Other (specify)  
 2 Brass 4 Galvanized steel 6 Concrete tile 9 ABS 12 None used (open hole)  
 SCREEN OR PERFORATION OPENINGS ARE:  
 1 Continuous slot 3 Mill slot 5 Gauzed wrapped 8 Saw cut 11 None (open hole)  
 2 Louvered shutter 4 Key punched 6 Wire wrapped 9 Drilled holes  
 7 Torch cut 10 Other (specify)  
 SCREEN-PERFORATED INTERVALS: From 24 ft. to 42 ft. From 15 ft. to 42 ft.  
 GRAVEL PACK INTERVALS: From 15 ft. to 42 ft.

6 GROUT MATERIAL: 1 Neat cement 2 Cement grout 3 Bentonite 4 Other  
 Grout Intervals: From 0 ft. to 15 ft. From 15 ft. to 42 ft.  
 What is the nearest source of possible contamination:  
 1 Septic tank 4 Lateral lines 7 Pit privy 10 Livestock pens 14 Abandoned water well  
 2 Sewer lines 5 Cess pool 8 Sewage lagoon 11 Fuel storage 15 Oil well/Gas well  
 3 Watertight sewer lines 6 Seepage pit 9 Feedyard 12 Fertilizer storage 16 Other (specify below)  
 13 Insecticide storage OPEN FIELD  
 Direction from well? How many feet?

FROM	TO	LITHOLOGIC LOG	FROM	TO	PLUGGING INTERVALS
0	2	Top soil			
2	8	Clay			
8	22	fine sand			
22	23	clay			
23	42	Sand			
42	-	Shale			

7 CONTRACTOR'S OR LANDOWNER'S CERTIFICATION: This water well was (1) constructed (2) reconstructed, or (3) plugged under my jurisdiction and was completed on (mo/day/year) 12-78-89 and this record is true to the best of my knowledge and belief. Kansas Water Well Contractor's License No. 378 This Water Well Record was completed on (mo/day/yr) 12-27-89 under the business name of Weninger Drilling by (signature) [Signature]

INSTRUCTIONS: Use typewriter or ball point pen. PLEASE PRESS FIRMLY and PRINT clearly. Please fill in blanks, underline or circle the correct answers. Send top three copies to Kansas Department of Health and Environment, Bureau of Water Protection, Topeka, Kansas 66620-7320. Telephone: 913-296-5514. Send one to WATER WELL OWNER and retain one for your records.

OFFICE USE ONLY

T

R

EW

SEC

1/4

1/4

1/4