


1 LOCATION OF WATER WELL: Fraction ~~NE~~ SE NW SW ~~SE~~ Section Number 9 Township Number T 31 S Range Number R 1 EW  
 County: Sumner Distance and direction from nearest town or city street address of well if located within city?

Mile Marker #25, Kansas Turnpike, Belle Plaine

2 WATER WELL OWNER: Merle Willey RR#, St. Address, Box #: RR 2 Box 131A City, State, ZIP Code: Belle Plaine, KS 67013 Board of Agriculture, Division of Water Resources Application Number: -

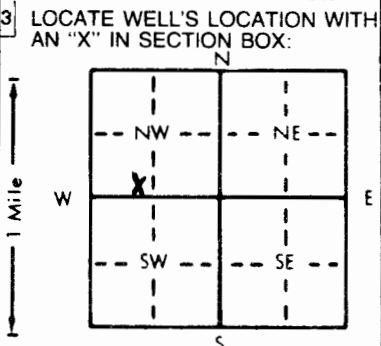

4 DEPTH OF COMPLETED WELL: 30.0 ft. ELEVATION: -  
 Depth(s) Groundwater Encountered 1. 24.0 ft. 2. - ft. 3. - ft.  
 WELL'S STATIC WATER LEVEL: 26.45 ft. below land surface measured on mo/day/yr 10-6-94  
 Pump test data: Well water was - ft. after - hours pumping - gpm  
 Est. Yield - gpm: Well water was - ft. after - hours pumping - gpm  
 Bore Hole Diameter 8.625 in. to 30.0 ft., and - in. to - ft.  
 WELL WATER TO BE USED AS:  
 5 Public water supply 8 Air conditioning 11 Injection well  
 1 Domestic 3 Feedlot 6 Oil field water supply 9 Dewatering 12 Other (Specify below)  
 2 Irrigation 4 Industrial 7 Lawn and garden only 10 Monitoring well MW-15  
 Was a chemical/bacteriological sample submitted to Department? Yes - No X; If yes, mo/day/yr sample was submitted -  
 Water Well Disinfected? Yes - No X

5 TYPE OF BLANK CASING USED:  
 1 Steel 3 RMP (SR) 5 Wrought iron 8 Concrete tile CASING JOINTS: Glued - Clamped -  
 2 PVC 4 ABS 6 Asbestos-Cement 9 Other (specify below) Welded -  
 7 Fiberglass Threaded X  
 Blank casing diameter 2" in. to 14.6 ft., Dia. - in. to - ft., Dia. - in. to - ft.  
 Casing height above land surface 36 in., weight Sch. 40 lbs./ft. Wall thickness or gauge No. -  
 TYPE OF SCREEN OR PERFORATION MATERIAL:  
 1 Steel 3 Stainless steel 5 Fiberglass 8 RMP (SR) 11 Other (specify) -  
 2 Brass 4 Galvanized steel 6 Concrete tile 9 ABS 12 None used (open hole)  
 SCREEN OR PERFORATION OPENINGS ARE:  
 1 Continuous slot 3 Mill slot 5 Gauzed wrapped 8 Saw cut 11 None (open hole)  
 2 Louvered shutter 4 Key punched 6 Wire wrapped 9 Drilled holes -  
 7 Torch cut 10 Other (specify) -  
 SCREEN-PERFORATED INTERVALS: From 14.6 ft. to 29.6 ft., From - ft. to - ft.  
 SAND GRAVEL PACK INTERVALS: From 13.6 ft. to 30.0 ft., From - ft. to - ft.  
 From - ft. to - ft., From - ft. to - ft.

6 GROUT MATERIAL: 1 Neat cement 2 Cement grout 3 Bentonite 4 Other -  
 Grout Intervals: From 6L ft. to 11.6 ft., From 11.6 ft. to 13.6 ft., From - ft. to - ft.  
 What is the nearest source of possible contamination:  
 1 Septic tank 4 Lateral lines 7 Pit privy 10 Livestock pens 14 Abandoned water well  
 2 Sewer lines 5 Cess pool 8 Sewage lagoon 11 Fuel storage 15 Oil well/Gas well  
 3 Watertight sewer lines 6 Seepage pit 9 Feedyard 12 Fertilizer storage 16 Other (specify below) Contaminated silt  
 13 Insecticide storage  
 Direction from well? How many feet?

FROM	TO	LITHOLOGIC LOG	FROM	TO	PLUGGING INTERVALS
6L	1.0'	Soil, clayey silt, brown			
1.0'	15.0'	Silty clay			
15.0'	19.0'	Silty sand			
19.0	23.0'	SAND, tan, fine to med.			
23.0	30.0'	Shale			
30.0	TD				

7 CONTRACTOR'S OR LANDOWNER'S CERTIFICATION: This water well was (1) constructed, (2) reconstructed, or (3) plugged under my jurisdiction and was completed on (mo/day/year) 10-4-94 and this record is true to the best of my knowledge and belief. Kansas Water Well Contractor's License No. 479 This Water Well Record was completed on (mo/day/yr) 10-22-94 under the business name of EBBERTS DRILLING by (signature) Egoan Ebberts