


1 LOCATION OF WATER WELL: County: Sumner Fraction: SE SW NW NE Section Number: 9 Township Number: T 31 S Range Number: R 1 E

Distance and direction from nearest town or city street address of well if located within city?  
Mile Marker #25, Kansas Turnpike, Belle Plaine

2 WATER WELL OWNER: Merle Willey  
 RR#, St. Address, Box #: RR 2 Box 131A  
 City, State, ZIP Code: Belle Plaine, KS 67013  
 Board of Agriculture, Division of Water Resources  
 Application Number: —

3 LOCATE WELL'S LOCATION WITH AN "X" IN SECTION BOX:

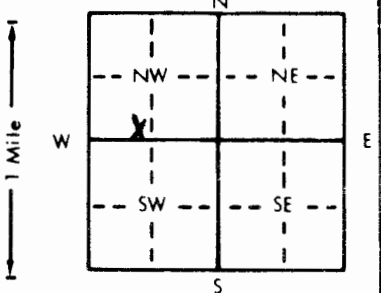

4 DEPTH OF COMPLETED WELL: 45.0 ft. ELEVATION: —  
 Depth(s) Groundwater Encountered 1. 38.0 ft. 2. — ft. 3. — ft.  
 WELL'S STATIC WATER LEVEL: 40.85 ft. below land surface measured on mo/day/yr 10-6-94  
 Pump test data: Well water was — ft. after — hours pumping — gpm  
 Est. Yield — gpm Well water was — ft. after — hours pumping — gpm  
 Bore Hole Diameter: 8.625 in. to 45.0 ft. and — in. to — ft.  
 WELL WATER TO BE USED AS:  
 1 Domestic 3 Feedlot 6 Oil field water supply 9 Dewatering 12 Other (Specify below)  
 2 Irrigation 4 Industrial 7 Lawn and garden only 10 Monitoring well mw-14  
 Was a chemical/bacteriological sample submitted to Department? Yes — No X If yes, mo/day/yr sample was submitted —  
 Water Well Disinfected? Yes — No X

5 TYPE OF BLANK CASING USED:  
 1 Steel 3 RMP (SR) 5 Wrought iron 8 Concrete tile CASING JOINTS: Glued — Clamped —  
2 PVC 4 ABS 6 Asbestos-Cement 9 Other (specify below) Welded —  
 7 Fiberglass Threaded X  
 Blank casing diameter 2" in. to 28.6 ft. Dia — in. to — ft. Dia — in. to — ft.  
 Casing height above land surface 36 in. weight Sch. 40 lbs./ft. Wall thickness or gauge No. —

TYPE OF SCREEN OR PERFORATION MATERIAL:  
 1 Steel 3 Stainless steel 5 Fiberglass 8 RMP (SR) 10 Asbestos-cement  
 2 Brass 4 Galvanized steel 6 Concrete tile 9 ABS 12 None used (open hole)  
 SCREEN OR PERFORATION OPENINGS ARE:  
 1 Continuous slot 3 Mill slot 5 Gauzed wrapped 8 Saw cut 11 None (open hole)  
 2 Louvered shutter 4 Key punched 6 Wire wrapped 9 Drilled holes  
 7 Torch cut 10 Other (specify) —

SCREEN-PERFORATED INTERVALS: From 28.6 ft. to 44.6 ft. From — ft. to — ft.  
 From — ft. to — ft. From — ft. to — ft.  
GRAVEL PACK INTERVALS: From 27.6 ft. to 45.0 ft. From — ft. to — ft.  
 From — ft. to — ft. From — ft. to — ft.

6 GROUT MATERIAL: 1 Neat cement 2 Cement grout 3 Bentonite 4 Other —  
 Grout Intervals: From 2 ft. to 25.6 ft. From 25.6 ft. to 27.6 ft. From — ft. to — ft.

What is the nearest source of possible contamination:  
 1 Septic tank 4 Lateral lines 7 Pit privy 10 Livestock pens 14 Abandoned water well  
 2 Sewer lines 5 Cess pool 8 Sewage lagoon 11 Fuel storage 15 Oil well/Gas well  
 3 Watertight sewer lines 6 Seepage pit 9 Feedyard 12 Fertilizer storage 16 Other (specify below)  
Contaminated site on adjacent property  
 Direction from well? — How many feet? —

FROM	TO	LITHOLOGIC LOG	FROM	TO	PLUGGING INTERVALS
<u>GL</u>	<u>2.0'</u>	<u>Soil, clayey silt, brown</u>			
	<u>18.0'</u>	<u>Silty clay, w/ fine sand</u>			
	<u>22.0'</u>	<u>Silty sand, orange-tan</u>			
	<u>34.0'</u>	<u>Sand, orange-tan, damp</u>			
	<u>45.0'</u>	<u>Shale</u>			
	<u>TD</u>				

7 CONTRACTOR'S OR LANDOWNER'S CERTIFICATION: This water well was (1) constructed, (2) reconstructed, or (3) plugged under my jurisdiction and was completed on (mo/day/year) 10-4-94 and this record is true to the best of my knowledge and belief. Kansas Water Well Contractor's License No. 479 This Water Well Record was completed on (mo/day/yr) 10-22-94 under the business name of EBERTS DRILLING by (signature) A Roger Eberts