

**WATER WELL PLUGGING RECORD Form WWC-5P**

KSA 82a-1212

ID NO.

mw-4


<b>1 LOCATION OF WATER WELL:</b> County: <u>ELK</u>	Fraction <u>SW 1/4 NW 1/4 SE 1/4</u>	Section Number <u>3</u>	Township Number <u>31</u>	Range Number <u>12</u> <input checked="" type="radio"/> <b>W</b>
--	---	----------------------------	------------------------------	---

Distance and direction from nearest town or city street address of well if located within city?

6TH AND KANSAS AVE HONOLTON, KS

mw-4

<b>2 WATER WELL OWNER:</b> <u>ROONEY KIRKPATRICK</u> RR#, St. Address, Box #: <u>P.O. Box 266</u> City, State ZIP Code: <u>HONOLTON, KS 67352</u>	<b>Global Positioning Systems</b> (decimal degrees, min. of 4 digits) Latitude: _____ Longitude: _____ Elevation: _____ Datum: _____ Data Collection Method: _____
---	---

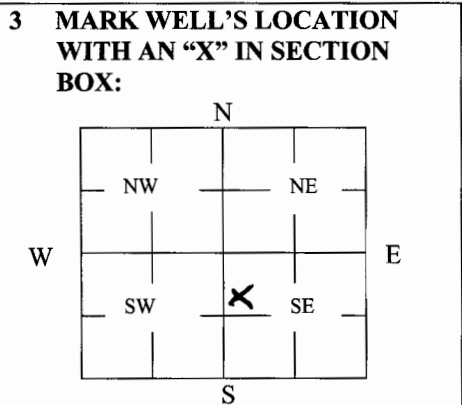

**4 DEPTH OF WELL** 12.80 ft.  
WELL'S STATIC WATER LEVEL 10.75 ft.  
WELL WAS USED AS:  
1 Domestic                      5 Public Water Supply                      9 Dewatering  
2 Irrigation                      6 Oil Field Water Supply                       10 Monitoring  
3 Feedlot                          7 Domestic (Lawn & Garden)                      11 Injection Well  
4 Industrial                      8 Air Conditioning                          12 Other \_\_\_\_\_  
Was a chemical/bacteriological sample submitted to Department? Yes \_\_\_\_\_ No

**5 TYPE OF BLANK CASING USED:**  
1 Steel                      3 RMP (SR)                      5 Wrought                      7 Fiberglass                      9 Other (Specify below)  
 2 PVC                      4 ABS                          6 Asbestos-Cement                      8 Concrete Tile

Blank casing diameter 2 in. Was casing pulled? Yes  No \_\_\_\_\_ If yes, how much ALL  
Casing height above or below land surface \_\_\_\_\_ in.

**6 GROUT PLUG MATERIAL:** 1 Neat cement    2 Cement grout    3 Bentonite     4 Other BENTONITE GROUT

Grout Plug Intervals: From 12.80 ft. to 3 ft., From \_\_\_\_\_ ft. to \_\_\_\_\_ ft., From \_\_\_\_\_ to \_\_\_\_\_ ft.

What is the nearest source of possible contamination:  
1 Septic tank                      6 Seepage pit                      11 Fuel Storage                      16 Other (specify below)  
2 Sewer lines                      7 Pit privy                          12 Fertilizer storage  
3 Watertight sewer lines                      8 Sewage lagoon                      13 Insecticide storage  
4 Lateral lines                      9 Feedyard                          14 Abandoned water well                      Direction from well? 999  
5 Cess pool                          10 Livestock pens                      15 Oil well/Gas well                      How many feet? 999

FROM	TO	PLUGGING MATERIALS	FROM	TO	PLUGGING MATERIALS
<u>12.80'</u>	<u>3'</u>	<u>BENTONITE GROUT</u>			
<u>3'</u>	<u>0'</u>	<u>NATIVE SOIL</u>			

**7 CONTRACTOR'S OR LANDOWNER'S CERTIFICATION:** This water well was plugged under my jurisdiction and was completed on (mo/day/year) 11/9/06 and this record is true to the best of my knowledge and belief. Kansas Water Well Contractor's License No. 704. This Water Well Record was completed on (mo/day/year) 11/27/06 under the business name of max S by (signature) David Perry

**INSTRUCTIONS:** Use typewriter or ballpoint pen. Please press firmly and print clearly. Please fill in blanks, underline or circle the correct answers. Send top three copies to Kansas Department of Health and Environment, Bureau of Water, Geology Section, 1000 SW Jackson St., Ste. 420, Topeka, Kansas 66612-1367. Telephone: 785/296-5522. Send one to Water Well Owner and retain one for your records. Visit us at <http://www.kdheks.gov/geo/waterwells>.