


1 LOCATION OF WATER WELL: Fraction SW 1/4 NW 1/4 SE 1/4 Section Number 3 Township Number 31 Range Number 12  W  
 County: ELK

Distance and direction from nearest town or city street address of well if located within city?

6TH AND KANSAS HONGTON, KS MW-7

2 WATER WELL OWNER: ROONEY KIRKPATRICK Global Positioning Systems (decimal degrees, min. of 4 digits)  
 RR#, St. Address, Box #: P.O. Box 266 Latitude: \_\_\_\_\_  
 City, State ZIP Code: HONGTON, KS 67352 Longitude: \_\_\_\_\_  
 Elevation: \_\_\_\_\_  
 Datum: \_\_\_\_\_  
 Data Collection Method: \_\_\_\_\_

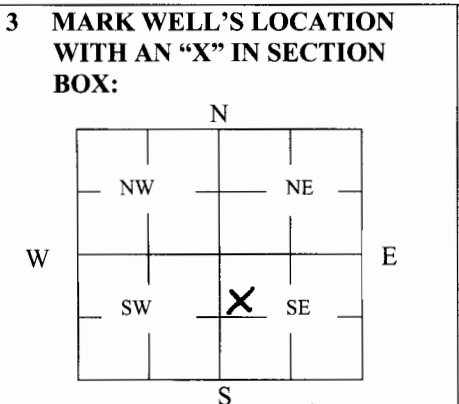

4 DEPTH OF WELL 14.30 ft.  
 WELL'S STATIC WATER LEVEL 10.42 ft.  
 WELL WAS USED AS:  
 1 Domestic                      5 Public Water Supply                      9 Dewatering  
 2 Irrigation                      6 Oil Field Water Supply                       10 Monitoring  
 3 Feedlot                          7 Domestic (Lawn & Garden)                      11 Injection Well  
 4 Industrial                      8 Air Conditioning                          12 Other \_\_\_\_\_  
 Was a chemical/bacteriological sample submitted to Department? Yes \_\_\_\_\_ No

5 TYPE OF BLANK CASING USED:  
 1 Steel      3 RMP (SR)      5 Wrought      7 Fiberglass      9 Other (Specify below) \_\_\_\_\_  
 2 PVC      4 ABS      6 Asbestos-Cement      8 Concrete Tile \_\_\_\_\_  
 Blank casing diameter 2 in. Was casing pulled? Yes  No \_\_\_\_\_ If yes, how much ALL  
 Casing height above or below land surface \_\_\_\_\_ in.

6 GROUT PLUG MATERIAL:      1 Neat cement      2 Cement grout      3 Bentonite       4 Other BENTONITE GROUT  
 Grout Plug Intervals: From 14.30 ft. to 3 ft., From \_\_\_\_\_ ft. to \_\_\_\_\_ ft., From \_\_\_\_\_ to \_\_\_\_\_ ft.

What is the nearest source of possible contamination:  
 1 Septic tank      6 Seepage pit      11 Fuel Storage      16 Other (specify below) \_\_\_\_\_  
 2 Sewer lines      7 Pit privy      12 Fertilizer storage      \_\_\_\_\_  
 3 Watertight sewer lines      8 Sewage lagoon      13 Insecticide storage      \_\_\_\_\_  
 4 Lateral lines      9 Feedyard      14 Abandoned water well      Direction from well? 999  
 5 Cess pool      10 Livestock pens      15 Oil well/Gas well      How many feet? 999

FROM	TO	PLUGGING MATERIALS	FROM	TO	PLUGGING MATERIALS
<u>14.30'</u>	<u>3'</u>	<u>BENTONITE GROUT</u>			
<u>3'</u>	<u>0'</u>	<u>NATIVE SOIL</u>			

7 CONTRACTOR'S OR LANDOWNER'S CERTIFICATION: This water well was plugged under my jurisdiction and was completed on (mo/day/year) 11/9/06 and this record is true to the best of my knowledge and belief. Kansas Water Well Contractor's License No. 704. This Water Well Record was completed on (mo/day/year) 11/27/06 under the business name of MAXS by (signature) David Pungell

INSTRUCTIONS: Use typewriter or ballpoint pen. Please press firmly and print clearly. Please fill in blanks, underline or circle the correct answers. Send top three copies to Kansas Department of Health and Environment, Bureau of Water, Geology Section, 1000 SW Jackson St., Ste. 420, Topeka, Kansas 66612-1367. Telephone: 785/296-5522. Send one to Water Well Owner and retain one for your records. Visit us at <http://www.kdheks.gov/geo/waterwells>.