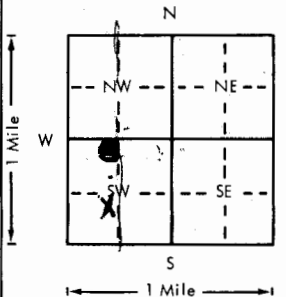
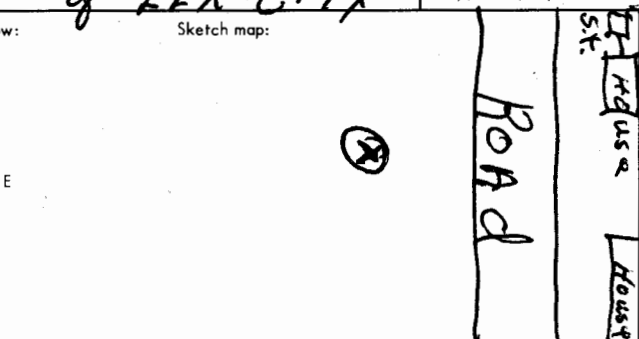


USE TYPEWRITER OR BALL
POINT PEN-PRESS FIRMLY,
PRINT CLEARLY.

WATER WELL RECORD
KSA 82a-1201-1215

Kansas Department of Health and
Environment-Division of Environment
(Water well Contractors)
Topeka, Kansas 66620

1. Location of well: <u>Montgomery</u>		County	Fraction <u>SW 1/4</u>	Section number <u>23</u>	Township number <u>T 31 S</u>	Range number <u>R 13 E</u>
2. Distance and direction from nearest town or city: <u>1/2 NO. W. OF</u>		3. Owner of well: <u>WALTER MERRICK</u>		R.R. or street: <u>RT 4</u>		
Street address of well location if in city: <u>8 ELLA CITY</u>		City, state, zip code: <u>SAVRE, OK 73662</u>				
4. Locate with "X" in section below:		Sketch map:		6. Bore hole dia. <u>8 3/4</u> in. Completion date <u>8-7-78</u>		
				Well depth <u>70</u> ft.		
5. Type and color of material		From	To	7. Cable tool <input checked="" type="checkbox"/> Rotary <input type="checkbox"/> Driven <input type="checkbox"/> Dug		
<u>TOP SOIL</u>		<u>0</u>	<u>2</u>	<input type="checkbox"/> Hollow rod <input type="checkbox"/> Jetted <input type="checkbox"/> Bored <input type="checkbox"/> Reverse rotary		
<u>Red CLAY</u>		<u>2</u>	<u>20</u>	8. Use: <input checked="" type="checkbox"/> Domestic <input type="checkbox"/> Public supply <input type="checkbox"/> Industry		
<u>River Gravel</u>		<u>20</u>	<u>33</u>	<input type="checkbox"/> Irrigation <input type="checkbox"/> Air conditioning <input type="checkbox"/> Stock		
<u>SHALE GRAVEL</u>		<u>33</u>	<u>70</u>	<input type="checkbox"/> Lawn <input type="checkbox"/> Oil field water <input type="checkbox"/> Other		
				9. Casing: Material <u>PVC</u> Height: <u>10</u> or below		
				Threaded <input type="checkbox"/> Welded <input type="checkbox"/> Surface <u>10</u> in.		
				RMP <input type="checkbox"/> PVC <u>GL</u> Weight <u>16</u> lbs./ft.		
				Dia. <u>5</u> in. to <u>60</u> ft. depth Wall Thickness: inches <u>3/8</u>		
				Dia. <u>5</u> in. to <u>60</u> ft. depth gage No. <u>258</u>		
				10. Screen: Manufacturer's name <u>M.P.I.</u>		
				Type <u>P.V.C.</u> Dia. <u>5</u>		
				Slot/gauze <u>25/1000</u> Length <u>10</u>		
				Set between <u>60</u> ft. and <u>70</u> ft.		
				<u>ft.</u> and <u>ft.</u>		
				Gravel pack? <u>YES</u> Size range of material <u>5/8</u>		
				11. Static water level: <u>20</u> ft. below land surface Date <u>8-7-78</u>		
				12. Pumping level below land surfaces:		
				<u>ft.</u> after <u>hrs.</u> pumping <u>g.p.m.</u>		
				<u>ft.</u> after <u>hrs.</u> pumping <u>g.p.m.</u>		
				Estimated maximum yield <u>2</u> g.p.m.		
				13. Water sample submitted: <u>YES</u> <input checked="" type="checkbox"/> No <input type="checkbox"/> Date <u>8-7-78</u>		
				14. Well head completion: <u>CAP</u>		
				<u>Pitless adapter</u> <u>16</u> inches above grade		
				15. Well grouted? <u>YES</u>		
				With: <input checked="" type="checkbox"/> Neat cement <input type="checkbox"/> Bentonite <input type="checkbox"/> Concrete		
				Depth: From <u>3</u> ft. to <u>10</u> ft.		
				16. Nearest source of possible contamination: <u>150</u> ft. <u>NO. E</u> Type <u>SEPTIC</u>		
				Well disinfected upon completion? <input checked="" type="checkbox"/> Yes <input type="checkbox"/> No		
				17. Pump: <input checked="" type="checkbox"/> Not installed		
				Type: <input type="checkbox"/> Submersible <input type="checkbox"/> Turbine		
				<input type="checkbox"/> Jet <input type="checkbox"/> Reciprocating		
				<input type="checkbox"/> Centrifugal <input type="checkbox"/> Other		
18. Elevation:		19. Remarks: <u>OWNER WILL INSTALL</u>		20. Water well contractor's certification:		
Topography: <u>X</u> Hill <input type="checkbox"/> Slope <input type="checkbox"/> Upland <input type="checkbox"/> Valley		<u>CONCRETE SLAB 4'X4'X4"</u>		This well was drilled under my jurisdiction and this report is true to the best of my knowledge and belief.		
		<u>x Jim Wagoner Jr. Foreman</u>		<u>Prewitt Const. 353</u>		
				Address <u>Box 744</u>		
				Signed <u>Arthur C. Prewitt</u> Date <u>8-7-78</u>		
				Authorized representative		

Forward the white, blue and pink copies to the Department of Health and Environment

Form WWC-5