
		RECORD		WWC-5		Division of W	1			MW1	
		Correction		ge in Well Use		esources App			Well ID		
		WATER WEL	L:	Fraction		Section Num		nship Numbe		ge Number	
	ty: Labette			SW ¼ SW ¼ SW ½ First:		13	1			B ■ E □ W	
	OWNER					ll is located					
Busines Address		2nd Place SE		istate Trust LLC	direction from nearest town or intersection): If at owner's address, check here:						
Address		ZIIU FIACE SE			2601 Ma	in St, Parso	ons, KS				
City:	Bothell		State: WA	ZIP: 98021							
3 LOCA	3 LOCATE WELL 4 DEPTH OF COMPLETED WELL:11.5							37.34089	a .	(decimal degrees)	
	WITH "X" IN Denth(s) Groundwater Encountered: 1)						itude:	-95 275	86	(decimal degrees)	
SECTION BOX:											
WELL'S STATIC WAT				TER LEVEL:2.	14 R .	Sou		de/Longitude:	- NAD	33 L NAD 27	
below land surface,				, measured on (mo-day	-yr). 5/25/20	21.7)	
					measured on (mo-day-yr)			enabled?			
Pump test data: Well w								☐ Topogra			
W	I	апет		s pumping	ater was			er:		• • • • • • • • • • • • • • • • • • • •	
sw-	SE	after		s pumping		00044					
Estimated Vield			gnm		6 Elevation: 900.11ft. ☐ Ground Level ■ TOC						
S Bore Hole Diameter:			8 in to 11.5	Sou	Source: Land Survey GPS Topographic Map						
1	mile			in. to	to ft.						
7 WELL WATER TO BE USED AS:											
1. Domestic	c:		ter Supply: well ID		Oil Field Wat	er Supply: lea	ise				
_	☐ Household 6. ☐ Dewatering: how				11. Test Hole: well ID						
_	& Garden	echarge: well IDg: well ID		☐ Cased ☐ Uncased ☐ Geotechnical 12. Geothermal: how many bores?							
_											
3. ☐ Feedle	☐ Irrigation 9. Environmental Remediation: well ID ☐ Feedlot ☐ Air Sparge ☐ Soil Vapor Extrac						a) Closed Loop ☐ Horizontal ☐ Vertical b) Open Loop ☐ Surface Discharge ☐ Inj. of Water				
4. Indust		ä	☐ Injection	LAN action		13. Other (specify):					
Was a chemical/bacteriological sample submitted to KDHE? ☐ Yes ■ No If yes, date sample was submitted:											
Water well disinfected? Yes No											
8 TYPE OF CASING USED: ☐ Steel ■ PVC ☐ Other											
Casing diameter 2 in to 4.5 ft. Diameter in to ft. Diameter in to ft.											
Casing diameter											
TYPE OF SCREEN OR PERFORATION MATERIAL:											
☐ Steel ☐ Stainless Steel ☐ Fiberglass ☐ PVC ☐ Other (Specify)											
☐ Brass ☐ Galvanized Steel ☐ Concrete tile ☐ None used (open hole)											
SCREEN OR PERFORATION OPENINGS ARE:											
☐ Continuous Slot ■ Mill Slot ☐ Gauze Wrapped ☐ Torch Cut ☐ Drilled Holes ☐ Other (Specify)											
□ Louvered Shutter □ Key Punched □ Wire Wrapped □ Saw Cut □ None (Open Hole)											
SCREEN-PERFORATED INTERVALS: From 4.5 ft. to 11.5 ft., From ft. to ft., From ft. to ft., From ft. to ft. GRAVEL PACK INTERVALS: From 3 ft. to 11.5 ft., From ft. to ft., From ft. to ft.											
9 GROUT MATERIAL: Neat cement Cement grout Bentonite Other											
Grout Intern	ale: Erom	1 Real Ce	3	ft., From	nionite 🔟	A From	 a	ft to	Α		
		ole contamination		It., FIOII	11. 10	10, 11011		11. 10	11.		
☐ Septic			teral Lines	☐ Pit Privy		Livestock P	ens	☐ Insecticio	le Storage		
☐ Sewer		□ Ce	ess Pool	☐ Sewage Lag	goon [Fuel Storag	e	☐ Abandon	_	/ell	
☐ Watertight Sewer Lines ☐ Seepage Pit ☐ Feedyard ☐ Fertilizer Storage ☐ Oil Well/Gas Well											
■ Other (Specify) on a UST site											
			THOLOG			ТО			LUCCDIC	DITEDUAL	
10 FROM 0	0.5		IHOLOG	IC LOG	FROM	10	LITHO. LO	G (cont.) or P	LUGGING	INTERVALS	
0.5	7	Concrete backfill clay ar	od rock		 						
7	11.5	Stiff yel clay w		oge .							
11.5	11.5	Limestone	7 TOCK II a	iys							
11.0		Limestone									
					Notes:						
					1						
11 CONT	RACTOR'	OR LANDOV	WNER'S	CERTIFICATION	This wat	er well was i	construct	ed, 🔲 recons	structed, or	plugged	
under my jurisdiction and was completed on (mo-day-year) .5/23/201.7 and this record is true to the best of my knowledge and belief.											
Kansas Water Well Contractor's License No. 527 This Water Well Record was completed on (moldsy-year) .6/2/2017											
under the b	usiness nam	e of .GeoUore	On for cool	constructed well to V	S	ignature	M. KU	fart	- Cume e	***************************************	
Mail 1 white copy along with a fee of \$5.00 for each constructed well to: Kansas Department of Health and Environment, Bureau of Water, GWTS Section, 1000 SW Jackson St., Suite 420, Topeka, Kansas 66612-1367. Mail one to Water Well Owner and retain one for your records. Telephone 785-296-5524.											
		t., Suite 420, Topek s.gov/waterwell/inde			ster well Ow SA 82a-1:		one for your rec	-	e 785-296-55 Revised 7 .		
· wie us at mile	TT TT TT KUITCK	CONTRACT FICILITIES			U = U = 1.				ALL TIBELL /	LUMUIU	

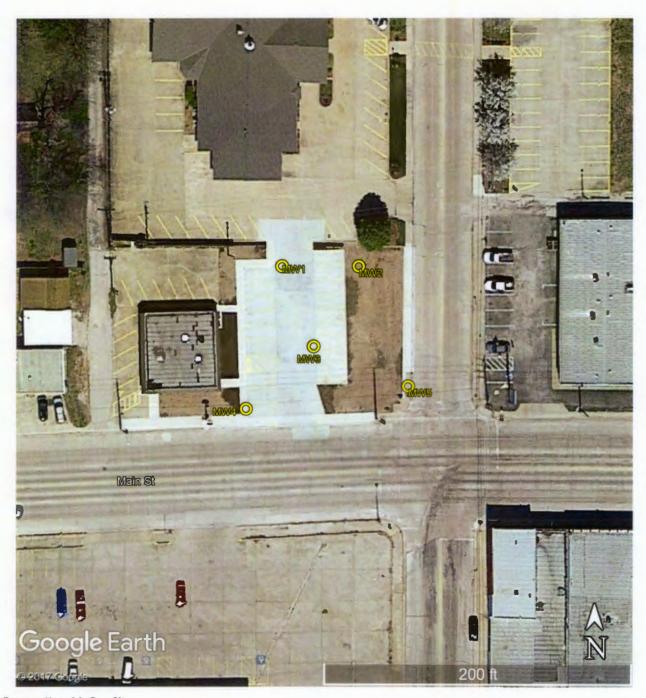

Former Kerr-McGee Site 2601 Main Street, Parsons, Kansas KDHE Project Code: U3-050-14779

Corrected GPS Coordinates:

MW1: 37.34089, -95.27586 MW2: 37.34090, -95.27569 MW3: 37.34076, -95.27579 MW4: 37.34065, -95.27594 MW5: 37.34069, -95.27558 RECEIVED

SEP 18 2017

BUREAU OF WATER