


1 LOCATION OF WATER WELL: <b>Sumner</b>	FRACTION <b>NE 1/4 SE 1/4 NW 1/4</b>	Section Number <b>9</b>	Township Number <b>T 31 S</b>	Range Number <b>R 2E E/W</b>
--	---	----------------------------	----------------------------------	---------------------------------

Distance and direction from nearest town or city street address of well if located within city?

**719 N. Greenwich Belle Plaine, Kansas**

WATER WELL OWNER: <b>WESSELS, Tom</b>	Board of Agriculture, Division of Water Resource
RR#, ST. ADDRESS, BOX #: <b>Rt. 2</b>	Application Number:
CITY, STATE, ZIP CODE: <b>Belle Plaine, Kansas 67013</b>	

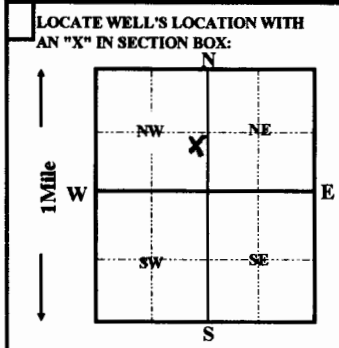

4 DEPTH OF <del>CONCRETE</del> <b>plugged</b> WELL <b>81</b> ft.	ELEVATION:	
Depth(s) groundwater Encountered <b>1</b> ft.	<b>2</b> ft.	<b>3</b> ft.
WELL'S STATIC WATER LEVEL <b>11</b> FT. BELOW LAND SURFACE MEASURED ON <b>11/15/1996</b>	mo/day/yr	
Pump test data:	Well water was	ft. after hours pumping gpm
Est. Yield	gpm: Well water was	ft. after hours pumping gpm
Bore Hole Diameter <b>unknown</b> in. to	ft. and	in. to ft.
WELL WATER TO BE USED AS:	5 Public water supply	8 Air conditioning
1 Domestic	3 Feedlot	6 Oil field water supply
2 Irrigation	4 Industrial	7 Lawn and garden only
6 Oil field water supply	9 Dewatering	11 Injection well
12 Other (Specify below)		
Was a chemical/bacteriological sample submitted to Department? Yes	No	; If yes, mo/day/yr sample was submitted
Water Well Disinfected? Yes	No	

5 TYPE OF CASING USED:	5 Wrought iron	8 Concrete tile	CASING JOINTS:	Glued	Clamped
1 Steel	3 RMP (SR)	6 Asbestos-Cement	9 Other (Specify below)	Welded	
2 PVC	4 ABS	7 Fiberglass		Threaded	
Blank casing Diameter <b>24</b> in. to	ft., Dia	in. to	ft., Dia	in. to	ft.
Casing height <del>above</del> <b>below</b> land surface <b>45</b> in.,	weight	lbs. / ft.	Wall thickness or gauge No.		
TYPE OF SCREEN OR PERFORATION MATERIAL:	5 Fiberglass	7 PVC	10 Asbestos-cement		
1 Steel	3 Stainless Steel	8 RMP (SR)	11 other (specify)	<b>N/A</b>	
2 Brass	4 Galvanized steel	9 ABS	12 None used (open hole)		
SCREEN OR PERFORATION OPENING ARE:	5 Gauzed wrapped	8 Saw cut	11 None (open hole)		
1 Continuous slot	3 Mill slot	6 Wire wrapped	9 Drilled holes		
2 Louvered shutter	4 Key punched	7 Torch cut	10 Other (specify)	<b>N/A</b>	
SCREEN-PERFORATION INTERVALS:	from	ft. to	ft., From	ft. to	ft.
GRAVEL PACK INTERVALS:	from	ft. to	ft., From	ft. to	ft.
	from	ft. to	ft., From	ft. to	ft.

6 GROUT MATERIAL:	1 Neat cement	2 Cement grout	3 Bentonite	4 Other <b>bentonite hole plug</b>
Grout Intervals: From <b>3</b> ft. to <b>10</b> ft.	ft. From	ft. to	ft. From	<b>10</b> ft. to <b>23</b> ft.
What is the nearest source of possible contamination:	10 Livestock pens	14 Abandon water well		
1 Septic tank	4 Lateral lines	7 Pit privy	11 Fuel storage	15 Oil well/Gas well
2 Sewer lines	5 Cess pool	8 Sewage lagoon	12 Fertilizer storage	16 Other (specify below)
3 Watertight sewer lines	6 Seepage pit	9 Feedyard	13 Insecticide storage	<b>None Apparent</b>

FROM	TO	LITHOLOGIC LOG	FROM	TO	PLUGGING INTERVALS
			<b>0</b>	<b>3</b>	<b>compacted topsoil</b>
			<b>3</b>	<b>10</b>	<b>cement grout</b>
			<b>10</b>	<b>23</b>	<b>bentonite hole plug</b>
			<b>23</b>	<b>51</b>	<b>chlorinated sand and gravel</b>

7 CONTRACTOR'S OR LANDOWNER'S CERTIFICATION: This water well was (1) constructed, (2) reconstructed, or (3) plugged under my jurisdiction and was completed on (mo/day/year) <b>11/15/1996</b> and this record is true to the best of my knowledge and belief. Kansas Water Well Contractor's License No. <b>236</b> This Water Well Record was completed on (mo/day/yr) <b>11/25/96</b>	Under the business name of <b>Harp Well &amp; Pump</b> by (signature)
<i>Todd S. Harp</i>	