


1 LOCATION OF WATER WELL: <b>Sumner</b>	FRACTION <b>NW 1/4 SE 1/4 NE 1/4</b>	Section Number <b>9</b>	Township Number <b>T 31 S</b>	Range Number <b>R 2E E/W</b>
--	---	----------------------------	----------------------------------	---------------------------------

Distance and direction from nearest town or city street address of well if located within city?  
**719 N. Greenwich Belle Plaine, Kansas**

WATER WELL OWNER: **WESSELS, Tom**  
 RR#, ST. ADDRESS, BOX #: **Rt. 2**  
 CITY, STATE, ZIP CODE: **Belle Plaine, Kansas 67013**

Board of Agriculture, Division of Water Resource  
Application Number:

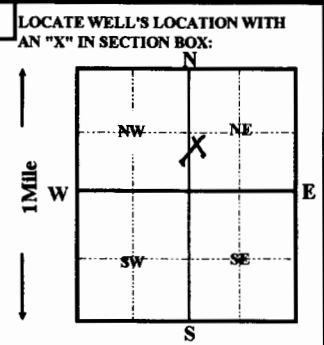

4 DEPTH OF ~~Plugged~~ WELL **61** ft. ELEVATION:  
 Depth(s) groundwater Encountered **1** ft. **2** ft. **3** ft.  
 WELL'S STATIC WATER LEVEL **12** FT. BELOW LAND SURFACE MEASURED ON **11/15/1996**  
 Pump test data: Well water was \_\_\_\_\_ ft. after \_\_\_\_\_ hours pumping \_\_\_\_\_ gpm  
 Est. Yield \_\_\_\_\_ gpm: Well water was \_\_\_\_\_ ft. after \_\_\_\_\_ hours pumping \_\_\_\_\_ gpm  
 Bore Hole Diameter ~~unknown~~ in. to \_\_\_\_\_ ft. and \_\_\_\_\_ in. to \_\_\_\_\_ ft.  
 WELL WATER ~~WAS~~ USED AS: **5** Public water supply **8** Air conditioning **11** Injection well  
**1** Domestic **3** Feedlot **6** Oil field water supply **9** Dewatering **12** Other (Specify below)  
**2** Irrigation **4** Industrial **7** Lawn and garden only **10** Monitoring well  
 Was a chemical/bacteriological sample submitted to Department? Yes \_\_\_\_\_ No \_\_\_\_\_ ; if yes, mo/day/yr sample was submitted \_\_\_\_\_  
 Water Well Disinfected? Yes \_\_\_\_\_ No \_\_\_\_\_

5 TYPE OF CASING USED:

1 Steel	3 RMP (SR)	5 Wrought iron	8 Concrete tile	CASING JOINTS: Glued Clamped
2 PVC	4 ABS	6 Asbestos-Cement	9 Other (Specify below)	Welded Threaded
Blank casing Diameter <b>24</b> in. to _____ ft., Dia _____ in. to _____ ft.		7 Fiberglass		
Casing height <del>below</del> land surface <b>48</b> in., weight _____ lbs. / ft.		Wall thickness or gauge No.		

TYPE OF SCREEN OR PERFORATION MATERIAL:

1 Steel	3 Stainless Steel	5 Fiberglass	8 RMP (SR)	11 other (specify) <b>N/A</b>
2 Brass	4 Galvanized steel	6 Concrete tile	9 ABS	12 None used (open hole)

SCREEN OR PERFORATION OPENING ARE:

1 Continous slot	3 Mill slot	5 Gauzed wrapped	8 Saw cut	11 None (open hole)
2 Louvered shutter	4 Key punched	6 Wire wrapped	9 Drilled holes	
		7 Torch cut	10 Other (specify) <b>N/A</b>	

SCREEN-PERFORATION INTERVALS: from \_\_\_\_\_ ft. to \_\_\_\_\_ ft., From \_\_\_\_\_ ft. to \_\_\_\_\_ ft.

GRAVEL PACK INTERVALS: from \_\_\_\_\_ ft. to \_\_\_\_\_ ft., From \_\_\_\_\_ ft. to \_\_\_\_\_ ft.

6 GROUT MATERIAL: 1 Neat cement 2 Cement grout 3 Bentonite 4 Other **bentonite hole plug**

Grout Intervals: From **3** ft. to **10** ft. From \_\_\_\_\_ ft. to \_\_\_\_\_ ft.

What is the nearest source of possible contamination:

1 Septic tank	4 Lateral lines	7 Pit privy	10 Livestock pens	14 Abandon water well
2 Sewer lines	5 Cess pool	8 Sewage lagoon	11 Fuel storage	15 Oil well/Gas well
3 Watertight sewer lines	6 Seepage pit	9 Feedyard	12 Fertilizer storage	16 Other (specify below)
			13 Insecticide storage	<b>None Apparent</b>

Direction from well?		LITHOLOGIC LOG		PLUGGING INTERVALS		
FROM	TO	FROM	TO	FROM	TO	
				<b>0</b>	<b>3</b>	<b>compacted topsoil</b>
				<b>3</b>	<b>10</b>	<b>cement grout</b>
				<b>10</b>	<b>25</b>	<b>bentonite hole plug</b>
				<b>25</b>	<b>61</b>	<b>chlorinated sand and gravel</b>

7 CONTRACTOR'S OR LANDOWNER'S CERTIFICATION: This water well was (1) constructed, (2) reconstructed, or (3) plugged under my jurisdiction and was completed on (mo/day/year) ..... **11/15/1996** ..... and this record is true to the best of my knowledge and belief. Kansas Water Well Contractor's License No. **236** This Water Well Record was completed on (mo/day/yr)..... **11/25/96** ..... Under the business name of **Harp Well & Pump Service, Inc** by (signature) *Todd S. Harp*