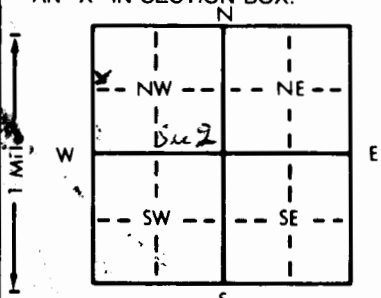


1 LOCATION OF WATER WELL: Fraction SW 1/4 NW 1/4 NW 1/4 Section Number 2 Township Number T 31 S Range Number R 2
 County: Sumner
 Distance and direction from nearest town or city street address of well if located within city?
4 1/2 Miles west of Udall, Kansas

2 WATER WELL OWNER: City of Udall, Kansas 67146
 RR#, St. Address, Box #: City Hall
 City, State, ZIP Code: Udall, KS 67146
 Board of Agriculture, Division of Water Resources
 Application Number: 37,257

3 LOCATE WELL'S LOCATION WITH AN "X" IN SECTION BOX:

 DEPTH OF COMPLETED WELL: 27 ft. ELEVATION: ft.
 Depth(s) Groundwater Encountered 1. 8' ft. 2. ft. 3. ft.
 WELL'S STATIC WATER LEVEL: 8' ft. below land surface measured on mo/day/yr May 15 - 1985
 Pump test data: Well water was 1.6 ft. after 2 hours pumping 200 gpm
 Est. Yield 200 gpm: Well water was 1.6 ft. after hours pumping gpm
 Bore Hole Diameter: 3.2 in. to 2.6 ft., and in. to ft.
 WELL WATER TO BE USED AS: 5 Public water supply 8 Air conditioning 11 Injection well
 1 Domestic 3 Feedlot 6 Oil field water supply 9 Dewatering 12 Other (Specify below)
 2 Irrigation 4 Industrial 7 Lawn and garden only 10 Observation well
 Was a chemical/bacteriological sample submitted to Department? Yes..... No.....; If yes, mo/day/yr sample was submitted
 Water Well Disinfected? Yes X No

5 TYPE OF BLANK CASING USED:
1 Steel 3 RMP (SR) 5 Wrought iron 8 Concrete tile CASING JOINTS: Glued Clamped
 2 PVC 4 ABS 6 Asbestos-Cement 9 Other (specify below) Welded
 7 Fiberglass Threaded.....
 Blank casing diameter 12 in. to ft., Dia. in. to ft., Dia. in. to ft.
 Casing height above land surface 8' in., weight lbs./ft. Wall thickness or gauge No. 375
 TYPE OF SCREEN OR PERFORATION MATERIAL:
 1 Steel 3 Stainless steel 5 Fiberglass 7 PVC 10 Asbestos-cement
 2 Brass 4 Galvanized steel 6 Concrete tile 8 RMP (SR) 11 Other (specify)
 12 None used (open hole)
 SCREEN OR PERFORATION OPENINGS ARE:
 1 Continuous slot 3 Mill slot 6 Wire wrapped 8 Saw cut 11 None (open hole)
 2 Louvered shutter 4 Key punched 7 Torch cut 9 Drilled holes
 SCREEN-PERFORATED INTERVALS: From 1.6 ft. to 2.6 ft., From ft. to ft.
 From ft. to ft., From ft. to ft.
 GRAVEL PACK INTERVALS: From 7 ft. to 2.6 ft., From ft. to ft.
 From ft. to ft., From ft. to ft.

6 GROUT MATERIAL: 1 Neat cement 2 Cement grout 3 Bentonite 4 Other
 Grout Intervals: From 2' above ground ft. to 7 ft., From ft. to ft.
 What is the nearest source of possible contamination:
 1 Septic tank 4 Lateral lines 7 Pit privy 10 Livestock pens 14 Abandoned water well
 2 Sewer lines 5 Cess pool 8 Sewage lagoon 11 Fuel storage 15 Oil well/Gas well
 3 Watertight sewer lines 6 Seepage pit 9 Feedyard 12 Fertilizer storage 16 Other (specify below)
 13 Insecticide storage
 Direction from well? NONE
 How many feet? NONE

FROM	TO	LITHOLOGIC LOG	FROM	TO	LITHOLOGIC LOG
1'	6'	Sandy Soil			
7'	10'	Fine Sand			
11'	14'	Coarse & medium Sand			
15'	19'	Coarse Sand			
20'	25'	Medium Sand			
26'	27'	Coarse Sand			
27'		Clay & Shell			

7 CONTRACTOR'S OR LANDOWNER'S CERTIFICATION: This water well was (1) constructed (2) reconstructed, or (3) plugged under my jurisdiction and was completed on (mo/day/year) May 11, 1985 and this record is true to the best of my knowledge and belief. Kansas Water Well Contractor's License No. 249 This Water Well Record was completed on (mo/day/yr) May 21, 1985 under the business name of HUNT DRILLING Co. by (signature) Walter A. Hunt

INSTRUCTIONS: Use typewriter or ball point pen, PLEASE PRESS FIRMLY and PRINT clearly. Please fill in blanks, underline or circle the correct answers. Send top three copies to Kansas Department of Health and Environment, Division of Environment, Environmental Geology Section, Topeka, KS 66620. Send one to WATER WELL OWNER and retain one for your records.