USE TYPEWRITER OR BALL POINT PEN-PRESS FIRMLY, PRINT CLEARLY.

WATER WELL RECORD
KSA 82a-1201-1215

Kansas Department of Health and Environment-Division of Environment
(Water well Contractors)
Topeka, Kansas 66620

1. Location of well:	County	Fraction	Section number	Township number	Range number
	Sumner	SW 1/4 SW 1/4 SW 1/4	11	T 31 S	R 2 E/~~W~~

2. Distance and direction from nearest town or city: X 1 West & 6 North of Oxford
Street address of well location if in city:

3. Owner of well: City of Oxford
R.R. or street: Oxford, Kansas 67119
City, state, zip code:

4. Locate with "X" in section below:

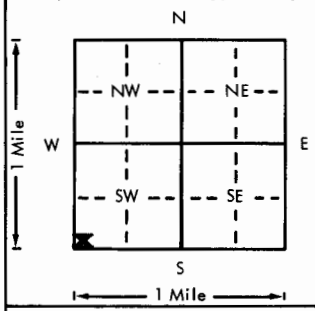

Sketch map:

5. Type and color of material	From	To
Top soil	000	2
Fine sand	2	15
Coarse sand - fine gravel, loose & clean	15	63
Shale -w/limestone streaks	63	80

(Use a second sheet if needed)

6. Bore hole dia. 8 in. Completion date
Well depth 50 ft. 12/5/78

7. __ Cable tool X Rotary __ Driven __ Dug
__ Hollow rod __ Jetted __ Bored __ Reverse rotary

8. Use: X Domestic __ Public supply __ Industry
__ Irrigation __ Air conditioning __ Stock
__ Lawn __ Oil field water __ Other

9. Casing: Material
Threaded __ Welded __
RMP PVC X
Dia. 5 in. to 50 ft. depth
Dia. in. to ft. depth
Height: Above ~~XXXX~~ Surface 18 in.
Weight lbs./ft.
Wall Thickness: inches or gage No. 160#

10. Screen: Manufacturer's name Certainteed
Type PVC Dia. 5"
Slot/gauze .06 Length 15
Set between 35 ft. and 50 ft.
ft. and ft.
Gravel pack yes Size range of material 1/8 x 1/4

11. Static water level: mo./day/yr.
12 ft. below land surface Date 12/5/78

12. Pumping level below land surfaces:
ft. after hrs. pumping g.p.m.
ft. after hrs. pumping g.p.m.
Estimated maximum yield g.p.m.

13. Water sample submitted: mo./day/yr.
Yes X No Date

14. Well head completion:
Pitless adapter 18 Inches above grade

15. Well grouted? yes
With: Neat cement Bentonite X Concrete
Depth: From 0 ft. to 10 ft.

16. Nearest source of possible contamination Septic Tank
ft. 150 Direction NW Type
Well disinfected upon completion? X Yes No

17. Pump: X Not installed
Manufacturer's name
Model number HP Volts
Length of drop pipe ft. capacity g.p.m.
Type:
__ Submersible __ Turbine
__ Jet __ Reciprocating
__ Centrifugal __ Other

18. Elevation:
Topography:
__ Hill
__ Slope
__ Upland
X Valley

19. Remarks:

20. Water well contractor's certification:
This well was drilled under my jurisdiction and this report is true to the best of my knowledge and belief.
Business name Layne Western Co. License No. 102
Address Wichita, Kansas
Signed Authorized representative Date 12/6/78

31 T — 2 R E/W — 11 Sec — SW 1/4 SW 1/4 SW 1/4

Forward the white, blue and pink copies to the Department of Health and Environment

Form WWC-5

MI-1023