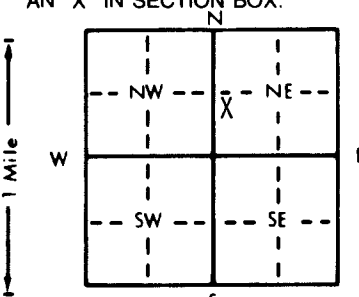


1 LOCATION OF WATER WELL: Fraction NW 1/4 SW 1/4 NE 1/4 Section Number 35 Township Number T 31 S Range Number R 20 EW

Distance and direction from nearest town or city street address of well if located within city?  
 2 Miles East of Parsons, KS on Hwy 160 Well No. 22-3

2 WATER WELL OWNER: U. S. Army  
 RR#, St. Address, Box #: Kansas Army Ammunition Plant Board of Agriculture, Division of Water Resources  
 City, State, ZIP Code: Parsons, KS Application Number:

3 LOCATE WELL'S LOCATION WITH AN "X" IN SECTION BOX:  

 4 DEPTH OF COMPLETED WELL: 18.5 ft. ELEVATION: 897.13 @ top of casing  
 Depth(s) Groundwater Encountered 1. ft. 2. ft. 3. ft.  
 WELL'S STATIC WATER LEVEL: 9.99 ft. below land surface measured on mo/day/yr  
 Pump test data: Well water was ft. after hours pumping gpm  
 Est. Yield gpm: Well water was ft. after hours pumping gpm  
 Bore Hole Diameter: in. to ft., and in. to ft.  
 WELL WATER TO BE USED AS:  
 5 Public water supply 8 Air conditioning 11 Injection well  
 1 Domestic 3 Feedlot 6 Oil field water supply 9 Dewatering 12 Other (Specify below)  
 2 Irrigation 4 Industrial 7 Lawn and garden only 10 Monitoring well  
 Was a chemical/bacteriological sample submitted to Department? Yes No; If yes, mo/day/yr sample was submitted  
 Water Well Disinfected? Yes No

5 TYPE OF BLANK CASING USED:  
 1 Steel 3 RMP (SR) 5 Wrought iron 8 Concrete tile CASING JOINTS: Glued Clamped  
 2 PVC 4 ABS 6 Asbestos-Cement 9 Other (specify below) Welded  
 7 Fiberglass Threaded  
 Blank casing diameter: 2 in. to 7.9 ft., Dia. in. to ft., Dia. in. to ft.  
 Casing height above land surface: 2.1 ft. in., weight lbs./ft. Wall thickness or gauge No. Sch 40  
 TYPE OF SCREEN OR PERFORATION MATERIAL:  
 1 Steel 3 Stainless steel 5 Fiberglass 8 RMP (SR) 10 Asbestos-cement  
 2 Brass 4 Galvanized steel 6 Concrete tile 9 ABS 11 Other (specify)  
 12 None used (open hole)  
 SCREEN OR PERFORATION OPENINGS ARE:  
 1 Continuous slot 3 Mill slot 5 Gauzed wrapped 8 Saw cut 11 None (open hole)  
 2 Louvered shutter 4 Key punched 6 Wire wrapped 9 Drilled holes  
 7 Torch cut 10 Other (specify) Factory Slot  
 SCREEN-PERFORATED INTERVALS: From 7.9 ft. to 17.9 ft., From ft. to ft.  
 From ft. to ft., From ft. to ft.  
 GRAVEL PACK INTERVALS: From 5.9 ft. to 18.5 ft., From ft. to ft.  
 From ft. to ft., From ft. to ft.

6 GROUT MATERIAL: 1 Neat cement 2 Cement grout 3 Bentonite 4 Other  
 Grout Intervals: From (3) 3.5 ft. to 5.9 ft., From (2) 0.0 ft. to 3.5 ft., From ft. to ft.  
 What is the nearest source of possible contamination:  
 1 Septic tank 4 Lateral lines 7 Pit privy 10 Livestock pens 14 Abandoned water well  
 2 Sewer lines 5 Cess pool 8 Sewage lagoon 11 Fuel storage 15 Oil well/Gas well  
 3 Watertight sewer lines 6 Seepage pit 9 Feedyard 12 Fertilizer storage 16 Other (specify below)  
 13 Insecticide storage Unknown  
 Direction from well? How many feet?

FROM	TO	LITHOLOGIC LOG	FROM	TO	PLUGGING INTERVALS
0.0	11.5	Clay			
11.5	19.5	Limestone			

7 CONTRACTOR'S OR LANDOWNER'S CERTIFICATION: This water well was (1) constructed (2) reconstructed, or (3) plugged under my jurisdiction and was completed on (mo/day/year) 9/16/92 and this record is true to the best of my knowledge and belief. Kansas Water Well Contractor's License No. 458 This Water Well Record was completed on (mo/day/yr) 9-29-93 under the business name of The Winnek Co. Inc. by signature [Signature]

INSTRUCTIONS: Use typewriter or ball point pen. PLEASE PRESS FIRMLY and PRINT clearly. Please fill in blanks, underline or circle the correct answers. Send top three copies to Kansas Department of Health and Environment, Bureau of Water, Topeka, Kansas 66620-0001. Telephone: 913-296-5545. Send one to WATER WELL OWNER and retain one for your records.

OFFICE USE ONLY  
T  
R  
EW  
SEC.  
1/4  
1/4  
1/4