

**WATER WELL PLUGGING RECORD Form WWC-5P**

KSA 82a-1212


ID NO.

MW-1-7

1 **LOCATION OF WATER WELL:** Fraction NE 1/4 NW 1/4 SW 1/4 NE 1/4 Section Number 26 Township Number T 31 S Range Number 20  E  W  
 County: Labette

Street/Rural Address of Well Location; if unknown, distance & direction from nearest town or intersection: If at owner's address, check here  1361' NORTH from 22450 Rd and Sheridan Rd.  
**Global Positioning Systems (GPS) information:**  
 Latitude: 37.321735000 (in decimal degrees)  
 Longitude: -95.183078056 (in decimal degrees)  
 Elevation: 892.72 ft  
 Horizontal Datum:  WGS84,  NAD83,  NAD27  
 Collection Method:

2 **WATER WELL OWNER:** USACE  
 RR#, St. Address, Box #: 601 E 12th St  
 City, State ZIP Code: KCMO 64106  
 GPS unit (Make/Model: Trimble Geoexplorer 6000)  
 Digital Map/Photo,  Topographic Map,  Land Survey  
 Est. Accuracy:  <3 m,  3-5 m,  5-15 m,  >15 m

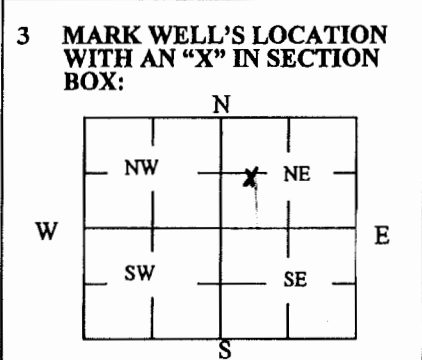

4 **DEPTH OF WELL** 22.7 ft.  
 WELL'S STATIC WATER LEVEL 5.5 ft  
 WELL WAS USED AS:  
 Domestic  Public Water Supply  Dewatering  
 Irrigation  Oil Field Water Supply  Monitoring  
 Feedlot  Domestic (Lawn & Garden)  Injection Well  
 Industrial  Air Conditioning  Other \_\_\_\_\_  
 Was a chemical/bacteriological sample submitted to Department? Yes  No

5 **TYPE OF BLANK CASING USED:**  
 Steel  RMP (SR)  Wrought  Fiberglass  Other (Specify below)  
 PVC  ABS  Asbestos-Cement  Concrete Tile  
 Blank casing diameter 2.0 in. Was casing pulled? Yes  No  If yes, how much 24.7'  
 Casing height above or below land surface 24 above in.

6 **GROUT PLUG MATERIAL:**  Neat cement  Cement grout  Bentonite  Other 3% bentonite by wt.  
 Grout Plug Intervals: From 22.7 ft. to 3.0 ft., From \_\_\_\_\_ ft. to \_\_\_\_\_ ft., From \_\_\_\_\_ ft. to \_\_\_\_\_ ft.  
 What is the nearest source of possible contamination: \* 90% Bentonite / cement grout mixture  
 Septic tank  Seepage pit  Fuel storage  Other (specify below)  
 Sewer lines  Pit privy  Fertilizer storage  
 Watertight sewer lines  Sewage lagoon  Insecticide storage  
 Lateral lines  Feedyard  Abandoned water well Direction from well? \_\_\_\_\_  
 Cess pool  Livestock pens  Oil well/Gas well How many feet? \_\_\_\_\_

FROM	TO	PLUGGING MATERIALS	FROM	TO	PLUGGING MATERIALS
0.0	3.0 ft	native soil			
3.0 ft	22.7 ft	90 Bentonite Grout			

7 **CONTRACTOR'S OR LANDOWNER'S CERTIFICATION:** This water well was plugged under my jurisdiction and was completed on (mo/day/year) 10/5/2010 and this record is true to the best of my knowledge and belief. Kansas Water Well Contractor's License No. NA. This Water Well Record was completed on (mo/day/year) 9/12/2010 under the business name of USACE by (signature) NA per US Gov

Send one white copy to Kansas Department of Health & Environment, Geology Section, 1000 SW Jackson Street, Ste. 420, Topeka, KS 66612-1367. Send one copy to WATER WELL OWNER and retain one for your records.  
 Visit us at <http://www.kdheks.gov/waterwell/index.html> Telephone 785-296-5524.

P00 816-389-3891

KSA82a-1212

Revised 1/20/2015