


WATER WELL PLUGGING RECORD Form WWC-5P KSA 82a-1212 ID NO.

MW-7-5

1 LOCATION OF WATER WELL: County: Labette Fraction: NE 1/4 SE 1/4 SW 1/4 NW 1/4 Section Number: 210 Township Number: T 31 S Range Number: 20 E W

Street/Rural Address of Well Location; if unknown, distance & direction from nearest town or intersection: If at owner's address, check here 925' North off the intersection of 22450 Rd and Sheridan Rd.
 Global Positioning Systems (GPS) information:
 Latitude: 37.319709444 (in decimal degrees)
 Longitude: -95.189770000 (in decimal degrees)
 Elevation: 921.52 ft.
 Horizontal Datum: WGS84, NAD83, NAD27
 Collection Method:

2 WATER WELL OWNER: USACE
 RR#, St. Address, Box #: 601 E 12th St
 City, State ZIP Code: KCMO 64106
 GPS unit (Make/Model): Trimble Geoexplorer 6000
 Digital Map/Photo, Topographic Map, Land Survey
 Est. Accuracy: < 3 m, 3-5 m, 5-15 m, > 15 m

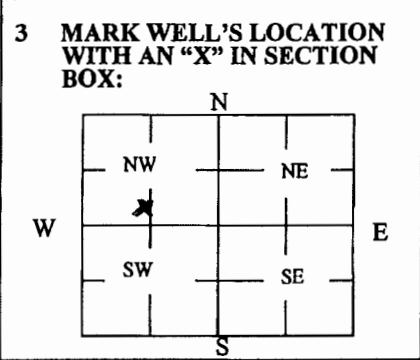

4 DEPTH OF WELL 16.2 ft.
 WELL'S STATIC WATER LEVEL 6.25 ft.
 WELL WAS USED AS:
 Domestic Irrigation Public Water Supply Dewatering
 Feedlot Oil Field Water Supply Monitoring
 Industrial Domestic (Lawn & Garden) Injection Well
 Air Conditioning
 Was a chemical/bacteriological sample submitted to Department? Yes No

5 TYPE OF BLANK CASING USED:
 Steel RMP (SR) Wrought Fiberglass Other (Specify below)
 PVC ABS Asbestos-Cement Concrete Tile
 Blank casing diameter 2.0 in. Was casing pulled? Yes No If yes, how much 13.3'
 Casing height above or below land surface 22 above in.

6 GROUT PLUG MATERIAL: Neat cement Cement grout Bentonite Other 3% bentonite by wt.
 Grout Plug Intervals: From 16.2 ft. to 3.0 ft., From _____ ft. to _____ ft., From _____ ft. to _____ ft.
 What is the nearest source of possible contamination: *N3% Bentonite/cement grout mixture
 Septic tank Seepage pit Fuel storage Other (specify below)
 Sewer lines Pit privy Fertilizer storage
 Watertight sewer lines Sewage lagoon Insecticide storage
 Lateral lines Feedyard Abandoned water well Direction from well? _____
 Cess pool Livestock pens Oil well/Gas well How many feet? _____

FROM	TO	PLUGGING MATERIALS	FROM	TO	PLUGGING MATERIALS
0.0	3.0 ft	native soil			
3 ft	16.2 ft	3% Bentonite Grout			

7 CONTRACTOR'S OR LANDOWNER'S CERTIFICATION: This water well was plugged under my jurisdiction and was completed on (mo/day/year) 10/5/2016 and this record is true to the best of my knowledge and belief. Kansas Water Well Contractor's License No. N/A. This Water Well Record was completed on (mo/day/year) 10/12/2016 under the business name of USACE by (signature) NA per US gov

Send one white copy to Kansas Department of Health & Environment, Geology Section, 1000 SW Jackson Street, Ste. 420, Topeka, KS 66612-1367. Send one copy to WATER WELL OWNER and retain one for your records.
 Visit us at <http://www.kdheks.gov/waterwell/index.html> Telephone 785-296-5524.

POC 816389 3891