


WATER WELL PLUGGING RECORD Form WWC-5P KSA 82a-1212 ID NO.

MW-5-5

1 **LOCATION OF WATER WELL:** Fraction NW 1/4 SE 1/4 SW 1/4 NW 1/4 Section Number 26 Township Number T 31 S Range Number 20 E W
 County: Labette

Street/Rural Address of Well Location; if unknown, distance & direction from nearest town or intersection: If at owner's address, check here 1025' NW off the intersection of 22450rd and Steward Rd
 Global Positioning Systems (GPS) information:
 Latitude: 37.31970778 (in decimal degrees)
 Longitude: -95.19146611 (in decimal degrees)
 Elevation: 923.90 ft.
 Horizontal Datum: WGS84, NAD83, NAD27
 Collection Method:

2 **WATER WELL OWNER:** USACE
 RR#, St. Address, Box #: 601 E 12th St
 City, State ZIP Code: KCMO 64106
 GPS unit (Make/Model: Trimble Geoexplorer 6000)
 Digital Map/Photo, Topographic Map, Land Survey
 Est. Accuracy: < 3 m, 3-5 m, 5-15 m, > 15 m

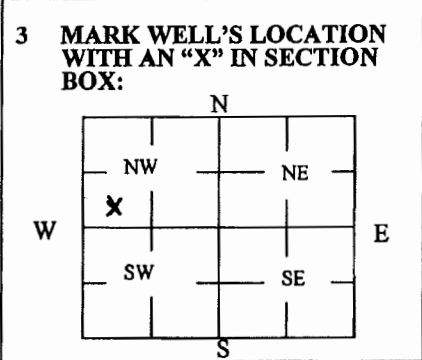

4 **DEPTH OF WELL** 17.7 ft.
WELL'S STATIC WATER LEVEL 4.4 ft
WELL WAS USED AS:
 Domestic Irrigation Feedlot Industrial
 Public Water Supply Oil Field Water Supply Domestic (Lawn & Garden) Air Conditioning
 Dewatering Monitoring Injection Well Other _____
 Was a chemical/bacteriological sample submitted to Department? Yes No

5 **TYPE OF BLANK CASING USED:**
 Steel PVC RMP (SR) ABS Wrought Asbestos-Cement Fiberglass Concrete Tile Other (Specify below) _____
 Blank casing diameter 2.0 in. Was casing pulled? Yes No If yes, how much 13.4'
 Casing height above or below land surface 23 above in.

6 **GROUT PLUG MATERIAL:** Neat cement Cement grout Bentonite Other 3% bentonite by wt. _____
 Grout Plug Intervals: From 17.7 ft. to 3.0 ft., From _____ ft. to _____ ft., From _____ ft. to _____ ft.
 What is the nearest source of possible contamination: * 3% Bentonite / cement grout mixture
 Septic tank Sewer lines Watertight sewer lines Lateral lines Cess pool
 Seepage pit Pit privy Sewage lagoon Feedyard Livestock pens
 Fuel storage Fertilizer storage Insecticide storage Abandoned water well Oil well/Gas well
 Other (specify below) _____
 Direction from well? _____
 How many feet? _____

FROM	TO	PLUGGING MATERIALS	FROM	TO	PLUGGING MATERIALS
0.0	3.0 ft	native soil			
3ft	17.7ft	3% Bentonite Grout			

7 **CONTRACTOR'S OR LANDOWNER'S CERTIFICATION:** This water well was plugged under my jurisdiction and was completed on (mo/day/year) 10/5/2016 and this record is true to the best of my knowledge and belief. Kansas Water Well Contractor's License No. N/A. This Water Well Record was completed on (mo/day/year) 10/12/2016 under the business name of USACE by (signature) NA per US Gov