

**WATER WELL PLUGGING RECORD Form WWC-5P**

KSA 82a-1212


ID NO.

MW-14-5

1 **LOCATION OF WATER WELL:** Fraction NE 1/4 SW 1/4 SW 1/4 NE 1/4 Section Number 35 Township Number T 31 S Range Number 20  E  W  
 County: Labette

Street/Rural Address of Well Location; if unknown, distance & direction from nearest town or intersection: If at owner's address, check here  1815' NE from the intersection of 21600 Rd and 21500 Rd  
**Global Positioning Systems (GPS) information:**  
 Latitude: 37.305171991 (in decimal degrees)  
 Longitude: -95.183166378 (in decimal degrees)  
 Elevation: 898.7 ft  
 Horizontal Datum:  WGS84,  NAD83,  NAD27  
 Collection Method:

2 **WATER WELL OWNER:** USACE  
 RR#, St. Address, Box #: 601 E. 12th St  
 City, State ZIP Code: KCMO 64106  
 GPS unit (Make/Model: Trimble Geoexplorer 6000)  
 Digital Map/Photo,  Topographic Map,  Land Survey  
 Est. Accuracy:  < 3 m,  3-5 m,  5-15 m,  > 15 m

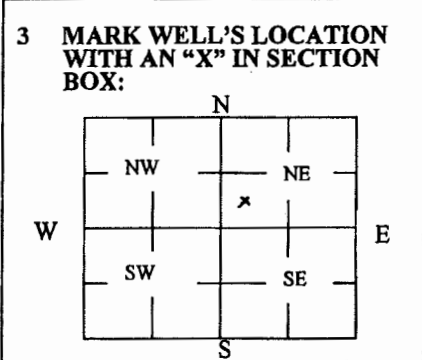

4 **DEPTH OF WELL** 23 ft.  
**WELL'S STATIC WATER LEVEL** 5.0 ft  
**WELL WAS USED AS:**  
 Domestic Irrigation Feedlot Industrial  
 Public Water Supply Oil Field Water Supply Domestic (Lawn & Garden) Air Conditioning  
 Dewatering Monitoring Injection Well Other \_\_\_\_\_  
 Was a chemical/bacteriological sample submitted to Department? Yes  No

5 **TYPE OF BLANK CASING USED:**  
 Steel  RMP (SR)  Wrought  Fiberglass  Other (Specify below)  
 PVC  ABS  Asbestos-Cement  Concrete Tile  
 Blank casing diameter 2 in. Was casing pulled? Yes  No  If yes, how much 23 ft.  
 Casing height above or below land surface \_\_\_\_\_ in.

6 **GROUT PLUG MATERIAL:**  Neat cement  Cement grout  Bentonite  Other \_\_\_\_\_  
 Grout Plug Intervals: From 23 ft. to 0 ft., From \_\_\_\_\_ ft. to \_\_\_\_\_ ft., From \_\_\_\_\_ ft. to \_\_\_\_\_ ft.  
\* N3% Bentonite/cement grout mixture  
 What is the nearest source of possible contamination:  
 Septic tank  Sewer lines  Watertight sewer lines  Lateral lines  Cess pool  
 Seepage pit  Pit privy  Sewage lagoon  Feedyard  Livestock pens  
 Fuel storage  Fertilizer storage  Insecticide storage  Abandoned water well  Oil well/Gas well  
 Other (specify below) \_\_\_\_\_  
 Direction from well? \_\_\_\_\_  
 How many feet? \_\_\_\_\_

FROM	TO	PLUGGING MATERIALS	FROM	TO	PLUGGING MATERIALS
<u>23 ft</u>	<u>3 ft</u>	<u>3% Bentonite Grout</u>			
<u>3 ft</u>	<u>0 ft</u>	<u>native soil</u>			

7 **CONTRACTOR'S OR LANDOWNER'S CERTIFICATION:** This water well was plugged under my jurisdiction and was completed on (mo/day/year) 10 May 2016 and this record is true to the best of my knowledge and belief. Kansas Water Well Contractor's License No. N/A. This Water Well Record was completed on (mo/day/year) 13 May 2016 under the business name of USACE by (signature) NA per US Gov

Send one white copy to Kansas Department of Health & Environment, Geology Section, 1000 SW Jackson Street, Ste. 420, Topeka, KS 66612-1367. Send one copy to WATER WELL OWNER and retain one for your records.  
 Visit us at <http://www.kdheks.gov/waterwell/index.html> Telephone 785-296-5524.