

Untitled Map


Write a description for your map.

Legend

- 27
- KS T31S R20E
- Lat Lon

Google Earth

1000 ft

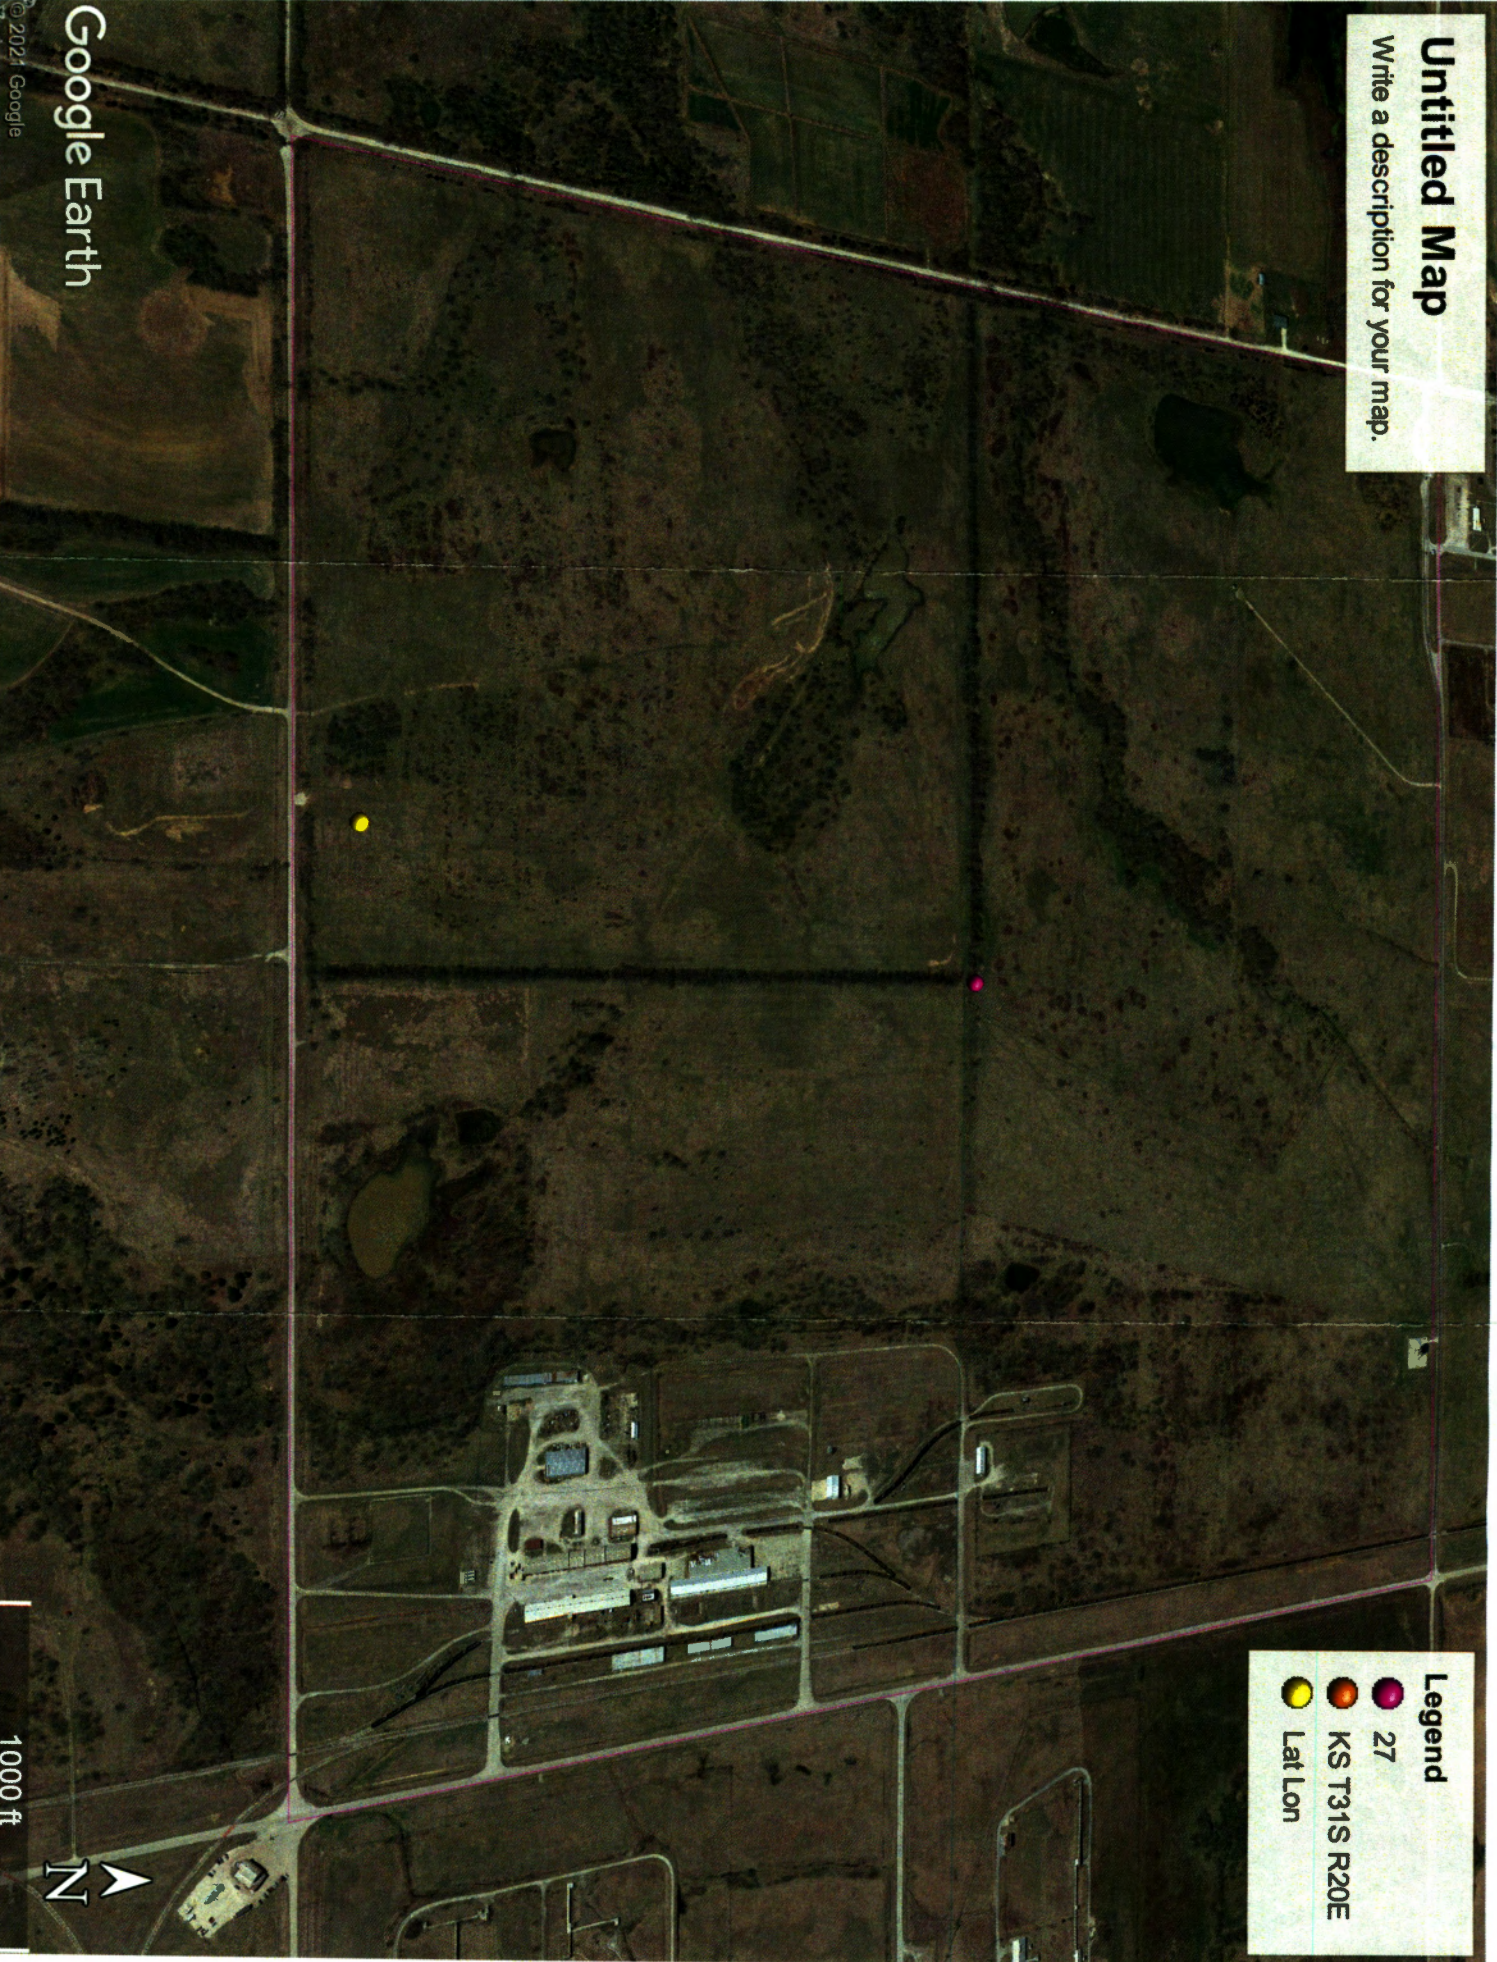

© 2021 Google