


1 LOCATION OF WATER WELL: Fraction NE SE $\frac{3}{4}$ $\frac{1}{4}$ Section Number 16 Township Number 31 S. Range Number 21 EN
 County: Labette

Distance and direction from nearest town or city street address of well if located within city?
Approx. 6 miles W. of McLure Ks. 2000 N 1824W Topeka Lot 4-River

2 WATER WELL OWNER: Crawford Rural Water Dist No. 6 Water Well Number 031487-00
 RR #, St. Address, Box #: P.O. Box 151 Girard Ks. 66743 Board of Agriculture, Division of Water Resources
 City, State, ZIP Code: _____ Application Number: _____

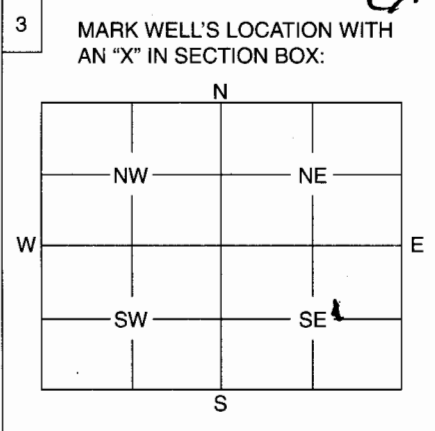

4 DEPTH OF WELL unknown ft. Debris in well
 WELL'S STATIC WATER LEVEL Level of river
3 ft away
 WELL WAS USED AS:
 1 Domestic 5 Public Water Supply 9 Dewatering
 2 Irrigation 6 Oil Field Water Supply 10 Monitoring Well
 3 Feedlot 7 Domestic (Lawn & Garden) 11 Injection Well
 4 Industrial 8 Air Conditioning 12 Other
 Was a chemical / bacteriological sample submitted to Department? Yes No
 If yes, mo/day/yr sample was submitted
 Water Well Disinfected: Yes No River water

5 TYPE OF BLANK CASING USED:
 1 Steel 3 RMP (SR) 5 Wrought 7 Fiberglass 9 Other (Specify below)
 2 PVC 4 ABS 6 Asbestos-Cement 8 Concrete Tile
 Blank casing diameter in. Was casing pulled? Yes No If yes, how much
 Casing height above or below land surface 0 in. Dropped

6 GROUT PLUG MATERIAL: 1 Neat cement 2 Cement grout 3 Bentonite 4 Other Rock
 Grout Plug Intervals: From bottom to 0 ft., From ft. to ft., From to ft.
 What is the nearest source of possible contamination:
 1 Septic tank 6 Seepage pit 11 Fuel storage 16 Other (specify below)
 2 Sewer lines 7 Pit privy 12 Fertilizer storage
 3 Watertight sewer lines 8 Sewage lagoon 13 Insecticide storage
 4 Lateral lines 9 Feedyard 14 Abandoned water well
 5 Cess pool 10 Livestock pens 15 Oil well/Gas well
 Direction from well? How many feet?

FROM	TO	PLUGGING MATERIALS
<u>bottom</u>	<u>-0'</u>	<u>Rock</u>

Neosho River is 3 ft from well
Inlet to Neosho River
Runs over site

7 CONTRACTOR'S OF LANDOWNER'S CERTIFICATION: This water well was plugged under my jurisdiction and was completed on (mo/day/year) 08/10/06 and this record is true to the best of my knowledge and belief. Kansas Water Well Contractor License No. 591
08/13/06 under the business name of K.W. Oil Well Serv Inc.
 by (signature) [Signature]

INSTRUCTIONS: Use typewriter or ball point pen. Please press firmly and print clearly. Please fill in blanks, underline or circle the correct answers. Send top three copies to Kansas Department of Health and Environment, Bureau of Water, Geology Section, 1000 SW Jackson St., Ste. 420, Topeka, Kansas 66612-1367. Telephone: 785/296-5522. Send one to Water Well Owner and retain one for your records.