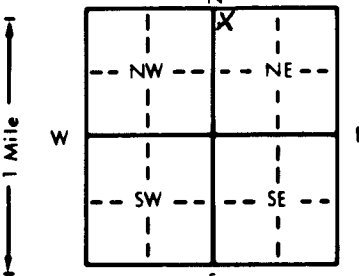


1 LOCATION OF WATER WELL: Fraction NW 1/4 NW 1/4 NE 1/4 Section Number 10 Township Number T 31 S Range Number R 3 E
 County: Cowley

Distance and direction from nearest town or city street address of well if located within city?
1 mile south and 1.6 miles east of Udell, Kansas

2 WATER WELL OWNER: Mr and Mrs Vincent McMullen
 RR#, St. Address, Box #: RR3 Box 71 K1 Board of Agriculture, Division of Water Resources
 City, State, ZIP Code: Udell, Kansas Application Number:

3 LOCATE WELL'S LOCATION WITH AN "X" IN SECTION BOX:

 4 DEPTH OF COMPLETED WELL: 42 ft. ELEVATION: Not known
 Depth(s) Groundwater Encountered 1. 40 ft. 2. _____ ft. 3. _____ ft.
 WELL'S STATIC WATER LEVEL: 37 ft. below land surface measured on mo/day/yr
 Pump test data: Well water was _____ ft. after _____ hours pumping _____ gpm
 Est. Yield: 10 gpm; Well water was _____ ft. after _____ hours pumping _____ gpm
 Bore Hole Diameter: 9 in. to 42 in. and _____ in. to _____ in.
 WELL WATER TO BE USED AS:
 1 Domestic 3 Feedlot 6 Oil field water supply 9 Dewatering 12 Other (Specify below)
 2 Irrigation 4 Industrial 7 Lawn and garden only 10 Monitoring well
 Was a chemical/bacteriological sample submitted to Department? Yes _____ No Yes If yes, mo/day/yr sample was submitted _____
 Water Well Disinfected? Yes No

5 TYPE OF BLANK CASING USED:
 1 Steel 3 RMP (SR) 5 Wrought iron 8 Concrete tile CASING JOINTS: Glued _____ Clamped _____
 2 PVC 4 ABS 6 Asbestos-Cement 9 Other (specify below) Welded _____
 Blank casing diameter: 5 in. to 22 ft. Dia _____ in. to _____ ft. Dia _____ in. to _____ ft.
 Casing height above land surface: _____ in., weight _____ lbs./ft. Wall thickness or gauge No. _____
 TYPE OF SCREEN OR PERFORATION MATERIAL:
 1 Steel 3 Stainless steel 5 Fiberglass 8 RMP (SR) 10 Asbestos-cement
 2 Brass 4 Galvanized steel 6 Concrete tile 9 ABS 11 Other (specify) _____
 SCREEN OR PERFORATION OPENINGS ARE:
 1 Continuous slot 3 Mill slot 5 Gauzed wrapped 8 Saw cut 11 None (open hole)
 2 Louvered shutter 4 Key punched 6 Wire wrapped 9 Drilled holes
 7 Torch cut 10 Other (specify) _____
 SCREEN-PERFORATED INTERVALS: From 22 ft. to 42 ft., From _____ ft. to _____ ft.
 GRAVEL PACK INTERVALS: From 22 ft. to 42 ft., From _____ ft. to _____ ft.

6 GROUT MATERIAL: 1 Neat cement 2 Cement grout 3 Bentonite 4 Other _____
 Grout intervals: From 0 ft. to 22 ft., From _____ ft. to _____ ft., From _____ ft. to _____ ft.
 What is the nearest source of possible contamination:
 1 Septic tank 4 Lateral lines 7 Pit privy 10 Livestock pens 14 Abandoned water well
 2 Sewer lines 5 Cess pool 8 Sewage lagoon 11 Fuel storage 15 Oil well/Gas well
 3 Watertight sewer lines 6 Seepage pit 9 Feedyard 12 Fertilizer storage 16 Other (specify below)
 13 Insecticide storage _____
 Direction from well? 75' SE How many feet? _____

FROM	TO	LITHOLOGIC LOG	FROM	TO	PLUGGING INTERVALS
0	5	Red-brown slightly silty clay soil			below sand at 40'.
5	13	Red-brown clay			
13	17 1/2	Hard gray clay-shale and gray green clay-shale			
17 1/2	20 1/2	gray and white-gray clays			
20 1/2	25	gray clay			
25	39	yellow limestone with white and black chert			Note: owner installed on pump and sealed casing.
39	40	gray shale			
40	42	Fine grained, varicolored sand made of quartz and shale fragments. Lost circulation at 40'. Could not regain circulation. Drilled to 42' but could not see samples			

7 CONTRACTOR'S OR LANDOWNER'S CERTIFICATION: This water well was (1) constructed (2) reconstructed, or (3) plugged under my jurisdiction and was completed on (mo/day/year) October 4, 1994 and this record is true to the best of my knowledge and belief. Kansas Water Well Contractor's License No. 579 This Water Well Record was completed on (mo/day/yr) October 4, 1994 under the business name of Stobbe Well Drilling and Geogical Serv (signature) William J. Stobbe

OFFICE USE ONLY
T
R
EW
SEC