


1 LOCATION OF WATER WELL: County: COWLEY Fraction: SE 1/4 NE 1/4 NW 1/4 Section Number: 9 Township Number: T 31 S Range Number: R 3 E/W

Distance and direction from nearest town or city street address of well if located within city?
1/3 mi. of UDALL E. Side Cherokee Strip Add. Lot 4, Block 1

2 WATER WELL OWNER: BOB WILLIAMS
 RR#, St. Address, Box #: 213 N. CLARK
 City, State, ZIP Code: UDALL KS 67146
 Board of Agriculture, Division of Water Resources
 Application Number:

3 LOCATE WELL'S LOCATION WITH AN "X" IN SECTION BOX:

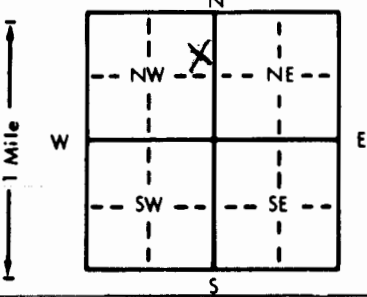

4 DEPTH OF COMPLETED WELL: 95 ft. ELEVATION: _____

Depth(s) Groundwater Encountered: 31 ft. 2. _____ ft. 3. _____ ft.
 WELL'S STATIC WATER LEVEL: 31 ft. below land surface measured on mo/day/yr

Pump test data: Well water was _____ ft. after _____ hours pumping _____ gpm
 Est. Yield: 15 gpm. Well water was _____ ft. after _____ hours pumping _____ gpm

Bore Hole Diameter: 10 in. to _____ ft., and _____ in. to _____ ft.
 WELL WATER TO BE USED AS:

- 5 Public water supply
- 8 Air conditioning
- 11 Injection well
- 1 Domestic
- 3 Feedlot
- 6 Oil field water supply
- 9 Dewatering
- 12 Other (Specify below)
- 2 Irrigation
- 4 Industrial
- 7 Lawn and garden only
- 10 Monitoring well

Was a chemical/bacteriological sample submitted to Department? Yes _____ No If yes, mo/day/yr sample was submitted _____
 Water Well Disinfected? Yes No

5 TYPE OF BLANK CASING USED:

- 1 Steel
- 3 RMP (SR)
- 6 Asbestos-Cement
- 9 Other (specify below)
- 2 PVC
- 4 ABS
- 7 Fiberglass
- CASING JOINTS: Glued Clamped Welded Threaded

Blank casing diameter: 5 in. to _____ ft., Dia. _____ in. to _____ ft., Dia. _____ in. to _____ ft.
 Casing height above land surface: +12 in., weight: 200 lbs./ft. Wall thickness or gauge No. _____

TYPE OF SCREEN OR PERFORATION MATERIAL:

- 1 Steel
- 3 Stainless steel
- 5 Fiberglass
- 8 RMP (SR)
- 11 Other (specify) _____
- 2 Brass
- 4 Galvanized steel
- 6 Concrete tile
- 9 ABS
- 12 None used (open hole)

SCREEN OR PERFORATION OPENINGS ARE:

- 1 Continuous slot
- 3 Mill slot
- 6 Wire wrapped
- 8 Saw cut
- 11 None (open hole)
- 2 Louvered shutter
- 4 Key punched
- 7 Torch cut
- 9 Drilled holes
- 10 Other (specify) _____

SCREEN-PERFORATED INTERVALS: From 75 ft. to 95 ft., From _____ ft. to _____ ft.
 From _____ ft. to _____ ft., From _____ ft. to _____ ft.

GRAVEL PACK INTERVALS: From 20 ft. to 95 ft., From _____ ft. to _____ ft.
 From _____ ft. to _____ ft., From _____ ft. to _____ ft.

6 GROUT MATERIAL: 1 Neat cement 2 Cement grout 3 Bentonite 4 Other _____

Grout intervals: From _____ ft. to _____ ft., From _____ ft. to _____ ft., From _____ ft. to _____ ft.

What is the nearest source of possible contamination:

- 1 Septic tank
- 4 Lateral lines
- 7 Pit privy
- 10 Livestock pens
- 14 Abandoned water well
- 2 Sewer lines
- 5 Cess pool
- 8 Sewage lagoon
- 11 Fuel storage
- 15 Oil well/Gas well
- 3 Watertight sewer lines
- 6 Seepage pit
- 9 Feedyard
- 12 Fertilizer storage
- 16 Other (specify below) _____
- 13 Insecticide storage

Direction from well? _____ How many feet? +50

FROM	TO	LITHOLOGIC LOG	FROM	TO	PLUGGING INTERVALS
0	2	dirt			
2	6	red gumbo			
6	50	yellow clay			
50	80	gray shale			
80	85	red rock			
85	95	gray lime			

7 CONTRACTOR'S OR LANDOWNER'S CERTIFICATION: This water well was (1) constructed, (2) reconstructed, or (3) plugged under my jurisdiction and was completed on (mo/day/year) July 5, 1988 and this record is true to the best of my knowledge and belief. Kansas Water Well Contractor's License No. 493 This Water Well Record was completed on (mo/day/yr) July 5, 1988 under the business name of Reiserer Well Drilling by (signature) Jerry Reiserer