


1	LOCATION OF WATER WELL:	Fraction	Section Number	Township Number	Range Number
County:	Cowley	W ¹ / ₂ NE ¹ / ₄ Less Row 1/4 1/4	02	31	04 E

Distance and direction from nearest town or city street address of well if located within city? N/A

2 WATER WELL OWNER: Richard E. & Linda F. Miller
 RR#, St. Address, Box #: 11457 62nd Rd Board of Agriculture, Division of Water Resources
 City, State, ZIP Code : Winfield, KS 67156 Application Number: N/A

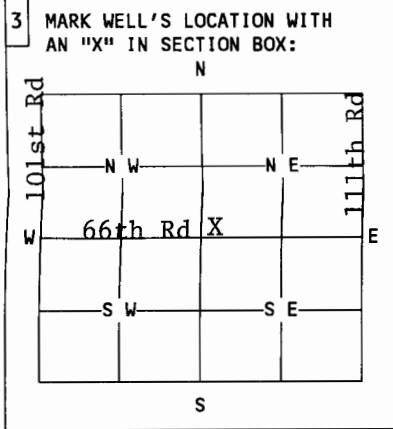

4 DEPTH OF WELL.....ft. 61 ft
 WELL'S STATIC WATER LEVEL.....ft. 35 ft
 WELL WAS USED AS:
 XX 1 Domestic 5 Public Water Supply 9 Dewatering
 2 Irrigation 6 Oil Field Water Supply 10 Monitoring Well
 3 Feedlot 7 Lawn and Garden Only 11 Injection Well
 4 Industrial 8 Air Conditioning 12 Other.XX.....
 Est 100 Yr old school house well
 Was a chemical/bacteriological sample submitted to Department? Yes....NoXX.
 If yes, mo/day/yr sample was submitted.....
 Water Well Disinfected: Yes.XX.. No.....
 Not used 40+ years est

5 TYPE OF BLANK CASING USED:
 XX1 Steel 3 RMP (SR) 5 Wrought 7 Fiberglass 9 Other (specify below)
 2 PVC 4 ABS 6 Asbestos-Cement 8 Concrete Tile
 Blank casing diameter.....9.....in. Was casing pulled? Yes.XX.. No..... If yes, how much.36"
 Casing height above or below land surface.....in. 36"

6 GROUT PLUG MATERIAL: 1 Neat cement 2 Cement grout 3 Bentonite 4 Other.....
 XX
 Grout Plug Intervals: From..5...ft. to..3...ft., From.....ft. toft., From..... to.....ft.
 What is the nearest source of possible contamination:
 1 Septic tank 6 Seepage pit 11 Fuel storage XX 16 Other (specify below)
 2 Sewer lines 7 Pit privy 12 Fertilizer storage
 3 Watertight sewer lines 8 Sewage lagoon 13 Insecticide storage
 4 Lateral lines 9 Feedyard 14 Abandoned water well old well not used
 5 Cess Pool 10 Livestock pens 15 Oil well/Gas well
 Direction from well?N/A..... How many feet?N/A.....

FROM	TO	PLUGGING MATERIALS
61 ft	26 ft	Sand
26 ft	6 ft	Packed Clay
6 ft	3 ft	Bentonite & Clay (packed)
3 ft	0 ft	Clay & Subsoil
0 ft	+1.5 ft	Soil

7 CONTRACTOR'S OR LANDOWNER'S CERTIFICATION: This water well was plugged under my jurisdiction and was completed on (mo/day/year). 04/24/2005..... and this record is true to the best of my knowledge and belief. Kansas Water Well Contractor's License No.N/A..... This Water Well Record was completed on (mo/day/year) ..04/28/2005..... under the business name ofN/A.....
 by (signature) *Richard E. Miller*

INSTRUCTIONS: Use typewriter or ball point pen. Please press firmly and print clearly. Please fill in blanks, underline or circle the correct answers. Send top three copies to Kansas Department of Health and Environment, Bureau of Water, Topeka, Kansas 66620-0001. Telephone: 913/296-3565. Send one to Water Well Owner and retain one for your records.


**NPS POLLUTION CONTROL FUND
ABANDONED WATER WELL COST-SHARE PROGRAM
WELL PLUGGING WORKSHEET**

WORKSHEET: (Use water quality bulletin to complete this worksheet, available through Cooperative Extension Service.)

County COWLEY Date 04-24-2005

Type of Well: Drilled or Hand-Dug (Circle One)

Diameter 9 inches Depth to water 35 ft. Total Depth 61 ft.

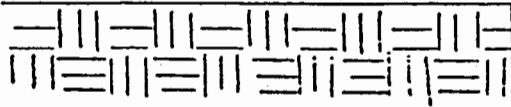


TOPSOIL: 3 ft. Drilled
4.5 ft. Hand-dug

PLUG: 3 ft. Drilled (Minimum)
6 in. Hand-dug (Minimum)

CLAY/SUBSOIL:
20 ft.

WATER:
35 ft.

As sand was added, water and additional chlorine was added (128 oz)

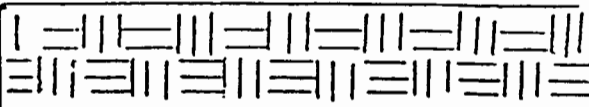

TOPSOIL: Material Needed **
7.1 cu. ft. 3 ft. of fill = 21.3 cu. ft.

PLUG:
.45 cu. ft. * x 3 ft. of plug = 1.35 cu. ft. plug
7.1 cu. ft. outside drilled well
36" to restore grout seal.

Handdug well, use diameter of well after removal of rock lining.

SUBSOIL:
.45 cu. ft./ft. * x 20 ft. of fill = 9 cu. ft. clay subsoil

CHLORINE:
4.1 oz./ft. x 35 ft. of water = 144 oz.
water & chlorine mix - 2 gals - (256) oz

SAND:
.45 cu. ft./ft. * x 35 ft. of sand = 15.75 cu. ft. mix

* Obtain cu. ft./ft. value from Extension Bulletin "Plugging Abandoned Wells"

** 27 cu. ft. = 1 yard


SITE PREPARATION: REMOVE PUMP AND COLUMN PIPE AND DEBRIS. EXCAVATE AROUND DRILLED WELL CASING AND CUT CASING 3 FEET BELOW GROUND LEVEL. STOCKPILE FILL MATERIAL ON SITE. LEAVE IN TRUCK IF POSSIBLE. HANDDUG WELLS NEED TRACTOR WITH FRONT END LOAD OR LARGE PRY BARS TO CAVE IN ROCK LINING.

SUBMIT WITH NPS-3

Continued.....

NPS POLLUTION CONTROL FUND
ABANDONED WATER WELL COST-SHARE PROGRAM
WELL PLUGGING WORKSHEET (CONTINUED)

Diagram = 160 acres or quarter section. Below:

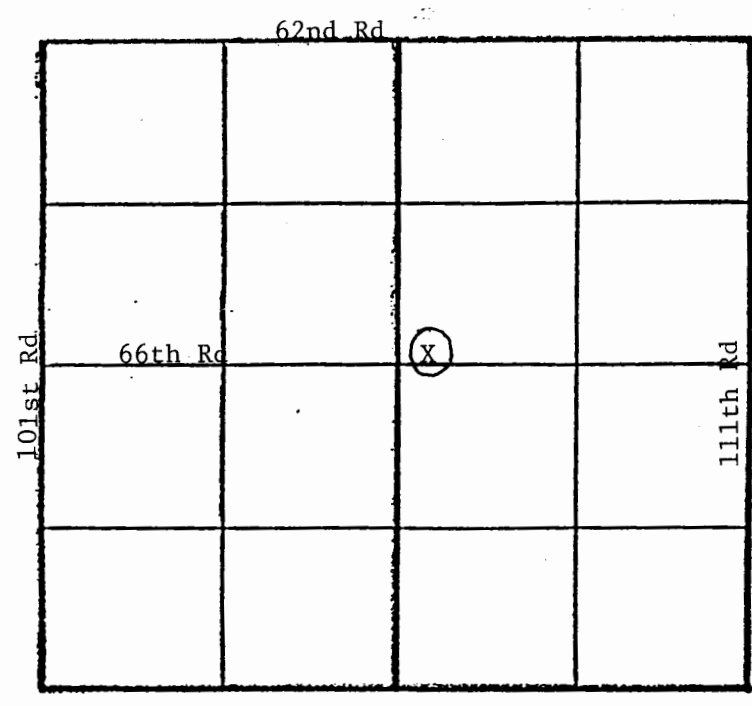

W¹/₂ NE¹/₄ Less Row
 LEGAL DESCRIPTION
 _____ 1/4 _____ 1/4 _____ 1/4
 Sec 02 T 31 R 04

LEGEND:
 O - Active Well
 I - Inactive Well
 (X) - Abandoned Well

1. Identify tract boundaries and define approximate location of abandoned water wells.

2. Total acres in tract 80.

3. [Signature]
 (Landowner Signature)

certifies that all known water wells on this tract have been identified.

SUBMIT ORIGINAL SIGNED COPY WITH NPS-3