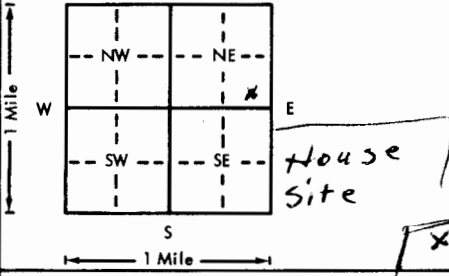


USE TYPEWRITER OR BALL POINT PEN-PRESS FIRMLY, PRINT CLEARLY.

WATER WELL RECORD
KSA 82a-1201-1215

Kansas Department of Health and Environment-Division of Environment
(Water well Contractors)
Topeka, Kansas 66620

1. Location of well:	County Cowley	Fraction SE 1/4 SE 1/4 NE 1/4	Section number 27	Township number T 31 S	Range number R 4 E/W
2. Distance and direction from nearest town or city: 2 W, 2 S. Floral, Kansas Street address of well location if in city:			3. Owner of well: Ray Shivers R. R. 1 Box 135 R.R. or street: Winfield, Kansas 67156 City, state, zip code:		
4. Locate with "X" in section below: N W E S 1 Mile		Sketch map: 		6. Bore hole dia. 8 in. Completion date 10-3-77 Well depth 80 ft.	
5. Type and color of material		From	To	7. <input checked="" type="checkbox"/> Cable tool <input type="checkbox"/> Rotary <input type="checkbox"/> Driven <input type="checkbox"/> Dug <input type="checkbox"/> Hollow rod <input type="checkbox"/> Jetted <input type="checkbox"/> Bored <input type="checkbox"/> Reverse rotary	
Soil		0	2	8. Use: <input checked="" type="checkbox"/> Domestic <input type="checkbox"/> Public supply <input type="checkbox"/> Industry <input type="checkbox"/> Irrigation <input type="checkbox"/> Air conditioning <input type="checkbox"/> Stock <input type="checkbox"/> Lawn <input type="checkbox"/> Oil field water <input type="checkbox"/> Other	
Shale, green-grey		2	30	9. Casing: Material Plastic Height: Above or below Threaded <input type="checkbox"/> Welded <input type="checkbox"/> Surface 12 in. RMP <input checked="" type="checkbox"/> PVC <input type="checkbox"/> Weight _____ lbs./ft. Dia. 6 in. to 80 ft. depth Wall Thickness: inches or Dia. _____ in. to _____ ft. depth gage No. 200	
Lime		30	36	10. Screen: Manufacturer's name J. & L. Type Slot 1/8" #1 Dia. 6" Slot/gauze RMP Length 3' 40" Set between 40 ft. and 80 ft. _____ ft. and _____ ft. Gravel pack <input checked="" type="checkbox"/> Yes <input type="checkbox"/> No Size range of material 1/4	
Shale, red-brown		36	38	11. Static water level: _____ mo./day/yr. 37 ft. below land surface Date 10-3-77	
Lime - buff		38	52	12. Pumping level below land surfaces: _____ ft. after _____ hrs. pumping _____ g.p.m. _____ ft. after _____ hrs. pumping _____ g.p.m. Estimated maximum yield 18 g.p.m.	
Limey Shale, grey		52	60	13. Water sample submitted: _____ mo./day/yr. Yes <input type="checkbox"/> No <input checked="" type="checkbox"/> Date _____	
Lime, grey		60	68	14. Well head completion: <input type="checkbox"/> Pitless adapter 12 Inches above grade	
Limey Shale, grey		68	80	15. Well grouted? <input checked="" type="checkbox"/> Yes With: <input checked="" type="checkbox"/> Neat cement <input type="checkbox"/> Bentonite <input type="checkbox"/> Concrete Depth: From 0 ft. to 30 ft.	
(Use a second sheet if needed)				16. Nearest source of possible contamination: ft. 1800 Direction N.E. Type Septic Well disinfected upon completion? <input checked="" type="checkbox"/> Yes <input type="checkbox"/> No	
				17. Pump: _____ Nat installed Manufacturer's name Bad Jacket Model number BVC 501 HP 1/2 Volts 230 Length of drop pipe 75 ft. capacity 8 g.p.m. Type: <input checked="" type="checkbox"/> Submersible <input type="checkbox"/> Turbine <input type="checkbox"/> Jet <input type="checkbox"/> Reciprocating <input type="checkbox"/> Centrifugal <input type="checkbox"/> Other	
18. Elevation:	19. Remarks:		20. Water well contractor's certification: This well was drilled under my jurisdiction and this report is true to the best of my knowledge and belief. Bailey Drilling Co 209 Business name _____ License No. _____ Address Burden KANS 67019 Signed Ronald E. Bailey Date 10-15-77 Authorized representative		
Topography: <input type="checkbox"/> Hill <input checked="" type="checkbox"/> Slope <input type="checkbox"/> Upland <input type="checkbox"/> Valley					

21
 4
 27
 SESENE
 1/4 1/4 1/4

Forward the white, blue and pink copies to the Department of Health and Environment

Form WWC-5