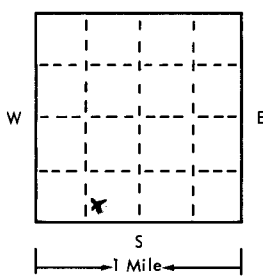
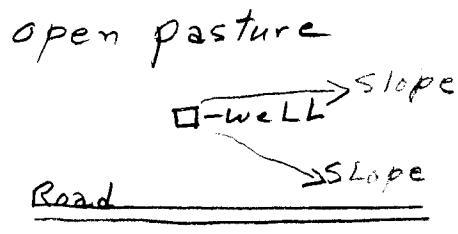


USE TYPEWRITER OR BALL POINT PEN-PRESS FIRMLY, PRINT CLEARLY.

3 1 5 5 E  
T R EW sec 1/4 1/4 1/4 No.

WATER WELL RECORD  
KSA 82a-1201-1215

Kansas State Dept. Of Health  
(Water Well Contractors)  
Forbes-Bldg. 740  
Topeka, Kansas 66620

1 Location of well:	County <b>Cowley</b>	Township name <b>Richland</b>	Fraction <b>SW/4 SE/4 SW/4</b>	Section number <b>4</b>	Town number <b>31</b>	Range number <b>5</b>
Distance and direction from nearest town or city: <b>3/4 mile west of Wilmot, Kans.</b>				3 Owner of well: <b>Donald Schifferdecker</b> Address: <b>Routes Winfield, Kansas</b>		
Locate with "X" in section below: N 		Sketch map: <b>open pasture</b> 		4 Well depth: <b>150</b> ft. Date of completion: <b>8-24-76</b> Well diameter <b>10</b> in.		
2		Type and color of material		From	To	5 <input checked="" type="checkbox"/> Cable tool <input type="checkbox"/> Rotary <input type="checkbox"/> Driven <input type="checkbox"/> Dug <input type="checkbox"/> Hollow rod <input type="checkbox"/> Jetted <input type="checkbox"/> Bored <input type="checkbox"/> Reverse rotary
						6 Use: <input checked="" type="checkbox"/> Domestic <input type="checkbox"/> Public supply <input type="checkbox"/> Industry <input type="checkbox"/> Irrigation <input type="checkbox"/> Air conditioning <input type="checkbox"/> Commercial <input type="checkbox"/> Test well <input type="checkbox"/>
						7 Casing: Material <b>#200 Plastic</b> Height: <b>above</b> below <input checked="" type="checkbox"/> Welded <input type="checkbox"/> Surface <b>24</b> in. Diam. <b>10</b> in. Weight <b>#200</b> lbs./ft. <b>6</b> in. to <b>150</b> ft. depth! Drive shoe? <input type="checkbox"/> Yes <input checked="" type="checkbox"/> No
						8 Screen: <b>Casing Perforated</b> Manufacturer <b>Bottom 10 Ft</b> Type _____ Dia. _____ Slot/gauze <b>1/16</b> Length _____ Set between <b>15</b> ft. and <b>150</b> ft. Fittings: _____ Gravel pack <input checked="" type="checkbox"/> Yes <input type="checkbox"/> No Size range of material _____
						9 Static water level: <b>52</b> ft. below land surface Date <b>8-22-76</b>
						10 Pumping level below land surfaces: <b>none</b> _____ ft. after _____ hrs. pumping _____ g.p.m. _____ ft. after _____ hrs. pumping _____ g.p.m. Estimated maximum yield <b>1</b> g.p.m.
						11 Water sample submitted: <input type="checkbox"/> Yes <input checked="" type="checkbox"/> No Date _____
						12 Well head completion: <b>n/a</b> <input type="checkbox"/> Pitless adapter <input type="checkbox"/> Inches above grade
						13 Well grouted? <input checked="" type="checkbox"/> Yes <input type="checkbox"/> No <input checked="" type="checkbox"/> Neat cement <input type="checkbox"/> Bentonite <input type="checkbox"/> _____ Depth: From <b>0</b> ft. to <b>15</b> ft.
						14 Nearest source of possible contamination: ft. _____ Direction _____ Type _____ Well disinfected upon completion? <input checked="" type="checkbox"/> Yes <input type="checkbox"/> No
						15 Pump: <input checked="" type="checkbox"/> Not installed Manufacturer's name _____ Model number _____ HP _____ Volts _____ Length of drop pipe _____ ft. capacity _____ g.m.p. Type: <input type="checkbox"/> Submersible <input type="checkbox"/> Turbine <input type="checkbox"/> Jet <input type="checkbox"/> Reciprocating <input type="checkbox"/> Centrifugal <input type="checkbox"/> Other
16 Remarks: elevation <b>Location of well 151;</b> <b>3240 Ft west of East section line; 72 Ft.</b> <b>north of South section line</b> Topography: <input checked="" type="checkbox"/> Hill <input type="checkbox"/> Slope <input type="checkbox"/> Upland <input type="checkbox"/> Valley				17 Water well contractor's certification: This well was drilled under my jurisdiction and this report is true to the best of my knowledge and belief. <b>Ronal Heffron Drilling #113</b> Business name _____ License No. _____ Address <b>Route 3 Winfield, Ks, 67756</b> Signed <b>Ronal Heffron</b> Date <b>9-19-76</b> Authorized representative		

31 5W 4 SW 5E 56