

CORRECTION(S) TO WATER WELL RECORD (WWC-5)

(to rectify lacking or incorrect information)

Location listed as:

Section-Township-Range: 5-31-6E

Fraction (1/4 1/4 1/4): None Given

County: Cowley

Location changed to:

5-315-6E

SW SW SE

Other changes: Initial statements: _____

Changed to: _____

Comments: Well owner's current address is 20606 72nd Rd.,
Burden, KS 67019

verification method: Legal description, well owner's address, area road
map on internet, position on plat map, and Burden &
Atlanta 1:24,000 topo. maps (buildings shown on initials: DRS date: 9/8/2005
map).

submitted by: Kansas Geological Survey, Data Resources Library, 1930 Constant Ave., Lawrence, KS 66047-3726

to: Kansas Dept of Health & Environment, Bureau of Water, 1000 SW Jackson, Suite 420, Topeka, KS 66612-1367.

#1


1 LOCATION OF WATER WELL:	Fraction	Section Number	Township Number	Range	Number
County: <u>Cowley</u>	¼ ¼ ¼	<u>5</u>	<u>31</u>	<u>6</u>	<u>EW</u>

Distance and direction from nearest town or city street address of well if located within city?

2 WATER WELL OWNER: JOE Haggard

RR #, St. Address, Box #: _____
 City, State, ZIP Code : _____

Board of Agriculture, Division of Water Resources
 Application Number: _____

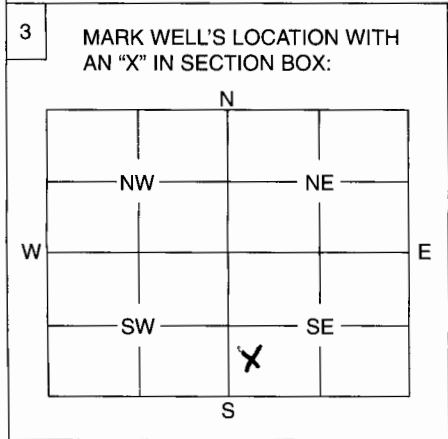

4 DEPTH OF WELL 22' ft.

WELL'S STATIC WATER LEVEL 5' ft.

WELL WAS USED AS:

<input checked="" type="checkbox"/> 1 Domestic	5 Public Water Supply	9 Dewatering
2 Irrigation	6 Oil Field Water Supply	10 Monitoring Well
3 Feedlot	7 Domestic (Lawn & Garden)	11 Injection Well
4 Industrial	8 Air Conditioning	12 Other

Was a chemical / bacteriological sample submitted to Department? Yes No X.....
 If yes, mo/day/yr sample was submitted

Water Well Disinfected: Yes X No

5 TYPE OF BLANK CASING USED:

1 Steel	3 RMP (SR)	5 Wrought	7 Fiberglass	<input checked="" type="checkbox"/> 9 Other (Specify below) <u>Hand Dug Rock</u>
2 PVC	4 ABS	6 Asbestos-Cement	8 Concrete Tile	

Blank casing diameter 6' in. Was casing pulled? N/A Yes No If yes, how much

Casing height above or below land surface

6 GROUT PLUG MATERIAL: 1 Neat cement 2 Cement grout 3 Bentonite 4 Other

Grout Plug Intervals: From ft. to ft., From ft. to ft., From to ft.

What is the nearest source of possible contamination:

1 Septic tank	6 Seepage pit	11 Fuel storage	<input checked="" type="checkbox"/> 16 Other (specify below)
2 Sewer lines	7 Pit privy	12 Fertilizer storage	<u>Livestock</u>
3 Watertight sewer lines	8 Sewage lagoon	13 Insecticide storage	
4 Lateral lines	9 Feedyard	14 Abandoned water well	
5 Cess pool	10 Livestock pens	15 Oil well/Gas well	

Direction from well? -0- How many feet? -0-

FROM	TO	PLUGGING MATERIALS
<u>0'</u>	<u>4½</u>	<u>TOP SOIL</u>
<u>4½</u>	<u>5'</u>	<u>BENTONITE PLUG</u>
<u>5'</u>	<u>17'</u>	<u>Composted Clayss/Fill rock</u>
<u>17'</u>	<u>22'</u>	<u>SAND (Washed)</u>

7 CONTRACTOR'S OF LANDOWNER'S CERTIFICATION: This water well was plugged under my jurisdiction and was completed on (mo/day/year) 6-22-05 and this record is true to the best of my knowledge and belief. Kansas Water Well Contractor's License No. N/A This Water Well Record was completed on (mo/day/year) _____ under the business name of Landowner by (signature) Joe Haggard

INSTRUCTIONS: Use typewriter or ball point pen. Please press firmly and print clearly. Please fill in blanks, underline or circle the correct answers. Send top three copies to Kansas Department of Health and Environment, Bureau of Water, Geology Section, 1000 SW Jackson St., Ste. 420, Topeka, Kansas 66612-1367. Telephone: 785/296-5522. Send one to Water Well Owner and retain one for your records.