

CORRECTION(S) TO WATER WELL RECORD (WWC-5)

(to rectify lacking or incorrect information)

Location listed as:

Section-Township-Range: 5-31-6

Fraction ($\frac{1}{4}$ $\frac{1}{4}$ $\frac{1}{4}$): None Given

County: Cowley

Location changed to:

5-315-6E

C SW SE

Other changes: Initial statements: _____

Changed to: _____

Comments: Well owner's current address is 20606 72nd Rd.,
Burden, KS 67019

verification method: Legal description, well owner's address, area road map
on internet, position on plat map, and Burden & Atlanta
1:24,000 topo. maps (buildings shown on map). initials: DRJ date: 10/27/2005

submitted by: Kansas Geological Survey, Data Resources Library, 1930 Constant Ave., Lawrence, KS 66047-3726
to: Kansas Dept of Health & Environment, Bureau of Water, 1000 SW Jackson, Suite 420, Topeka, KS 66612-1367.

#2


1	LOCATION OF WATER WELL:	Fraction	Section Number	Township Number	Range Number
	County: <u>Cowley</u>	$\frac{1}{4}$ $\frac{1}{4}$ $\frac{1}{4}$	<u>5</u>	<u>31</u>	<u>6</u> E/W

Distance and direction from nearest town or city street address of well if located within city?

2 WATER WELL OWNER: JOE Haggard

RR #, St. Address, Box #: _____
 City, State, ZIP Code: _____

Board of Agriculture, Division of Water Resources
 Application Number: _____

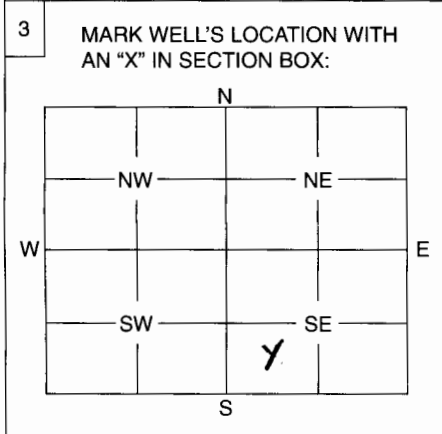

4 DEPTH OF WELL 24 ft.

WELL'S STATIC WATER LEVEL 12' ft.

WELL WAS USED AS:

<input checked="" type="radio"/> 1 Domestic	5 Public Water Supply	9 Dewatering
<input type="radio"/> 2 Irrigation	6 Oil Field Water Supply	10 Monitoring Well
<input type="radio"/> 3 Feedlot	7 Domestic (Lawn & Garden)	11 Injection Well
<input type="radio"/> 4 Industrial	8 Air Conditioning	12 Other

Was a chemical / bacteriological sample submitted to Department? Yes No

If yes, mo/day/yr sample was submitted

Water Well Disinfected: Yes No

5 TYPE OF BLANK CASING USED:

1 Steel	3 RMP (SR)	5 Wrought	7 Fiberglass	<input checked="" type="radio"/> 9 Other (Specify below)
2 PVC	4 ABS	6 Asbestos-Cement	8 Concrete Tile	

Blank casing diameter 6" Was casing pulled? Yes No If yes, how much

Casing height above or below land surface in.

Hand Dug Well - Rock -

6 GROUT PLUG MATERIAL: 1 Neat cement 2 Cement grout 3 Bentonite 4 Other

GROUT PLUG INTERVALS: From ft. to ft., From ft. to ft., From to ft.

What is the nearest source of possible contamination:

1 Septic tank	6 Seepage pit	11 Fuel storage	<input checked="" type="radio"/> 16 Other (specify below)
2 Sewer lines	7 Pit privy	12 Fertilizer storage	<u>Livestock</u>
3 Watertight sewer lines	8 Sewage lagoon	13 Insecticide storage	
4 Lateral lines	9 Feedyard	14 Abandoned water well	
5 Cess pool	10 Livestock pens	15 Oil well/Gas well	

Direction from well? - 0 - How many feet? - 0 -

FROM	TO	PLUGGING MATERIALS
<u>0'</u>	<u>4 1/2'</u>	<u>TOP SOIL</u>
<u>4 1/2'</u>	<u>5'</u>	<u>Bentonite Plug</u>
<u>5'</u>	<u>12'</u>	<u>Compacted Clays/Rock fill</u>
<u>12'</u>	<u>24'</u>	<u>SAND (WASTED)</u>

7 CONTRACTOR'S OF LANDOWNER'S CERTIFICATION: This water well was plugged under my jurisdiction and was completed on (mo/day/year) N/A 6-22-05 and this record is true to the best of my knowledge and belief. Kansas Water Well Contractor's License No. N/A This Water Well Record was completed on (mo/day/year)
 by (signature) [Signature]
 under the business name of Joe Haggard

INSTRUCTIONS: Use typewriter or ball point pen. Please press firmly and print clearly. Please fill in blanks, underline or circle the correct answers. Send top three copies to Kansas Department of Health and Environment, Bureau of Water, Geology Section, 1000 SW Jackson St., Ste. 420, Topeka, Kansas 66612-1367. Telephone: 785/296-5522. Send one to Water Well Owner and retain one for your records.