

CORRECTION TO WATER WELL RECORD (WWC-5)

The following correction(s) was made to the attached WWC-5 log, in order to file the item or to rectify lacking or incorrect information.

Fraction ( 1/4 1/4 . 1/4) Section-Township-Range changed:

listed as SE, SE, NE

changed to SE, SE, NE, sec. 35, T 31S, R 6E.

Other changes made:

Initial statements: \_\_\_\_\_

\_\_\_\_\_  
\_\_\_\_\_

Changed to: \_\_\_\_\_

\_\_\_\_\_

verification method: written description & position on plat map on form, & Burden & Cambridge 1:24,000 topo maps. initials: RR date: 12/18/98

submitted by: Kansas Geological Survey, Data Resources Library, 1930 Constant Ave., Lawrence, KS 66047-3726  
to: Kansas Dept of Health & Environment Bureau of Water Industrial Programs, Bldg 283, Forbes Field, KS 66620


WATER WELL RECORD Form WWC-5 KSA 82a-1212

1 LOCATION OF WATER WELL: County: Cowley Fraction: SE 1/4 SE 1/4 NE 1/4 Section Number: Township Number: T S Range Number: R E/W

Distance and direction from nearest town or city street address of well if located within city?  
1 mile East and 1/2 South of Burden

2 WATER WELL OWNER: Ma... .. RR#, St. Address, Box #: Board of Agriculture, Division of Water Resources Application Number:  
 City, State, ZIP Code: Burden Ks

3 LOCATE WELL'S LOCATION WITH AN "X" IN SECTION BOX:

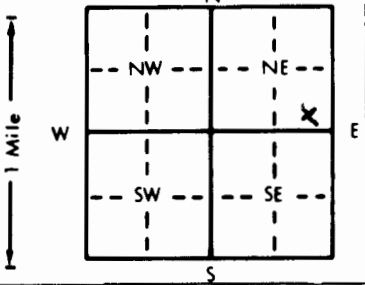

4 DEPTH OF COMPLETED WELL: 200' ft. ELEVATION:  
 Depth(s) Groundwater Encountered 1. 90 ft. 2. ft. 3. ft.  
 WELL'S STATIC WATER LEVEL ft. below land surface measured on mo/day/yr  
 Pump test data: Well water was ft. after hours pumping gpm  
 Est. Yield 4 gpm; Well water was ft. after hours pumping gpm  
 Bore Hole Diameter: 9 3/4 in. to .ft., and .in. to .ft.  
 WELL WATER TO BE USED AS: 5 Public water supply 8 Air conditioning 11 Injection well  
1 Domestic 3 Feedlot 6 Oil field water supply 9 Dewatering 12 Other (Specify below)  
 2 Irrigation 4 Industrial 7 Lawn and garden only 10 Monitoring well  
 Was a chemical/bacteriological sample submitted to Department? Yes.....No. X; If yes, mo/day/yr sample was sub-  
 mitted Water Well Disinfected? Yes X No

5 TYPE OF BLANK CASING USED: 5 Wrought iron 8 Concrete tile CASING JOINTS: Glued X Clamped  
 1 Steel 3 RMP (SR) 6 Asbestos-Cement 9 Other (specify below) Welded  
2 PVC 4 ABS 7 Fiberglass Threaded  
 Blank casing diameter 5 in. to 80 ft., Dia .in. to .ft., Dia .in. to .ft.  
 Casing height above land surface 18 in., weight lbs./ft. Wall thickness or gauge No. 1604  
 TYPE OF SCREEN OR PERFORATION MATERIAL: 7 PVC 10 Asbestos-cement  
 1 Steel 3 Stainless steel 5 Fiberglass 8 RMP (SR) 11 Other (specify)  
 2 Brass 4 Galvanized steel 6 Concrete tile 9 ABS 12 None used (open hole)  
 SCREEN OR PERFORATION OPENINGS ARE: 5 Gauzed wrapped 8 Saw cut 11 None (open hole)  
 1 Continuous slot 3 Mill slot 6 Wire wrapped 9 Drilled holes  
 2 Louvered shutter 4 Key punched 7 Torch cut 10 Other (specify)  
 SCREEN-PERFORATED INTERVALS: From 80 ft. to 200 ft., From .ft. to .ft.  
 From .ft. to .ft., From .ft. to .ft.  
 GRAVEL PACK INTERVALS: From 25 ft. to 200 ft., From .ft. to .ft.  
 From .ft. to .ft., From .ft. to .ft.

6 GROUT MATERIAL: 1 Neat cement 2 Cement grout 3 Bentonite 4 Other  
 Grout Intervals: From 0 ft. to 25 ft., From .ft. to .ft., From .ft. to .ft.  
 What is the nearest source of possible contamination:  
 1 Septic tank 4 Lateral lines 7 Pit privy 10 Livestock pens 14 Abandoned water well  
 2 Sewer lines 5 Cess pool 8 Sewage lagoon 11 Fuel storage 15 Oil well/Gas well  
 3 Watertight sewer lines 6 Seepage pit 9 Feedyard 12 Fertilizer storage 16 Other (specify below)  
 13 Insecticide storage  
 Direction from well? How many feet?

FROM	TO	LITHOLOGIC LOG	FROM	TO	PLUGGING INTERVALS
0	200	lime & shale			

7 CONTRACTOR'S OR LANDOWNER'S CERTIFICATION: This water well was (1) constructed, (2) reconstructed, or (3) plugged under my jurisdiction and was completed on (mo/day/year) 6-97 and this record is true to the best of my knowledge and belief. Kansas Water Well Contractor's License No. 625 This Water Well Record was completed on (mo/day/yr), 7-10-98 under the business name of MSPerson Drilling by signature Billy S. M...

INSTRUCTIONS: Use typewriter or ball point pen. PLEASE PRESS FIRMLY and PRINT clearly. Please fill in blanks, underline or circle the correct answers. Send top three copies to Kansas Department of Health and Environment, Bureau of Water, Topeka, Kansas 66620-0001. Telephone: 913-296-5545. Send one to WATER WELL OWNER and retain one for your records.

OFFICE USE ONLY