


1 LOCATION OF WATER WELL: Fraction SW NW NW Section Number 31 Township Number T32S Range Number R16 CBW
 County: Montgomery

Distance and direction from nearest town or city street address of well if located within city?
100 N. 10th St., Independence, KS - Well located 100' S. of property

2 WATER WELL OWNER: Costal Mart, Inc.
 RR #, St. Address, Box #: Att: Brian Kellmann
 City, State, ZIP Code: 2 N. Nevada Ave. Colorado Springs, CO 80903 Board of Agriculture, Division of Water Resources Application Number:

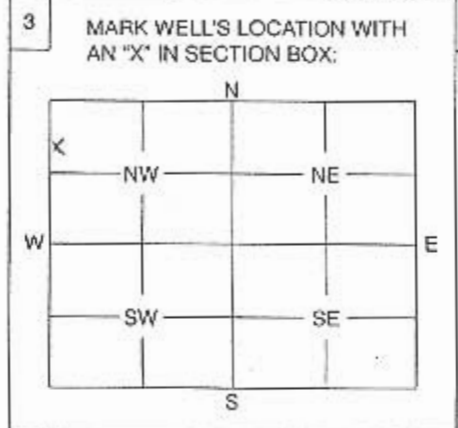

4 DEPTH OF WELL 15 ft.
 WELL'S STATIC WATER LEVEL NA ft. - Not measured, well casing destroyed.
 WELL WAS USED AS:
 1 Domestic 2 Irrigation 3 Feedlot 4 Industrial 5 Public Water Supply 6 Oil Field Water Supply 7 Domestic (Lawn & Garden) 8 Air Conditioning 9 Dewatering 10 Monitoring Well 11 Injection Well 12 Other
 Was a chemical / bacteriological sample submitted to Department? Yes No
 If yes, mo/day/yr sample was submitted
 Water Well Disinfected: Yes No

5 TYPE OF BLANK CASING USED:
 1 Steel 2 PVC 3 RMP (SR) 4 ABS 5 Wrought 6 Asbestos-Cement 7 Fiberglass 8 Concrete Tile 9 Other (Specify below)
 Blank casing diameter 2 in. Was casing pulled? Yes No If yes, how much 05'
 Casing height above or below land surface 36 in. - previously pulled up by construction crew.

6 GROUT PLUG MATERIAL: 1 Neat cement 2 Cement grout 3 Bentonite 4 Other
 Grout Plug Intervals: From 2 ft. to 15.5 ft., From ft. to ft., From to ft.
 What is the nearest source of possible contamination:
 1 Septic tank 2 Sewer lines 3 Watertight sewer lines 4 Lateral lines 5 Cess pool 6 Seepage pit 7 Pit privy 8 Sewage lagoon 9 Feedyard 10 Livestock pens 11 Fuel storage 12 Fertilizer storage 13 Insecticide storage 14 Abandoned water well 15 Oil well/Gas well 16 Other (specify below)
 Direction from well? NE How many feet? 75

FROM	TO	PLUGGING MATERIALS
0	2'	Clean soil
2	15.5	3/8" Bentonite chips

Casing broken off approx 5' BGS so could not pull casing. Drilled over casing then plugged w/ 3/8" bentonite.
 - Well was destroyed during construction.

7 CONTRACTOR'S OF LANDOWNER'S CERTIFICATION: This water well was plugged under my jurisdiction and was completed on (mo./day/year) 3/30/05 and this record is true to the best of my knowledge and belief, Kansas Water Well Contractor's License No. 705 This Water Well Record was completed on (mo./day/year) 3/30/05 under the business name of HAS DEX by (signature) [Signature]

INSTRUCTIONS: Use typewriter or ball point pen. Please press firmly and print clearly. Please fill in blanks, underline or circle the correct answers. Send top three copies to Kansas Department of Health and Environment, Bureau of Water, Geology Section, 1000 SW Jackson St., Ste. 420, Topeka, Kansas 66612-1367. Telephone: 785/298-5522. Send one to Water Well Owner and retain one for your records.