


MW-07B

WATER WELL PLUGGING RECORD Form WWC-5P KSA 82a-1212 ID NO. []

1 LOCATION OF WATER WELL: Fraction 1/4 NW 1/4 NW 1/4 SE 1/4 Section Number 18 Township Number T 32 S Range Number 6 [] E [] W
County: Sumner

Street/Rural Address of Well Location; if unknown, distance & direction from nearest town or intersection: If at owner's address, check here [] BNSF Tie Plant - Wellington, KS
1,000ft North of E. 20th St. and 1,000ft West of Seneca Rd.
Global Positioning Systems (GPS) information:
Latitude: 37.2664 (in decimal degrees)
Longitude: 97.3532 (in decimal degrees)
Elevation:
Datum: [] WGS84, [x] NAD83, [] NAD27
Collection Method:
[x] GPS unit (Make/Model: Garmin 60CS)
[] Digital Map/Photo, [] Topographic Map, [] Land Survey
Est. Accuracy: [] < 3 m, [x] 3-5 m, [] 5-15 m, [] > 15 m

2 WATER WELL OWNER: BNSF Railway
RR#, St. Address, Box #: 4515 Kansas Ave.
City, State ZIP Code: Kansas City, KS 66106

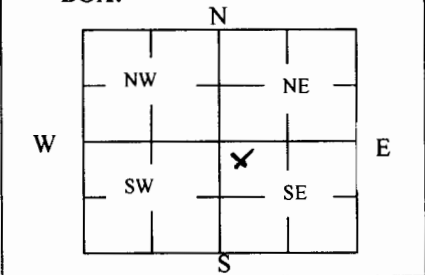

4 DEPTH OF WELL 30 ft.
WELL'S STATIC WATER LEVEL _____ ft.
WELL WAS USED AS:
[] Domestic [] Public Water Supply [] Dewatering
[] Irrigation [] Oil Field Water Supply [x] Monitoring
[] Feedlot [] Domestic (Lawn & Garden) [] Injection Well
[] Industrial [] Air Conditioning [] Other _____
Was a chemical/bacteriological sample submitted to Department? Yes [] No [x]

5 TYPE OF BLANK CASING USED:
[] Steel [] RMP (SR) [] Wrought [] Fiberglass [] Other (Specify below)
[x] PVC [] ABS [] Asbestos-Cement [] Concrete Tile
Blank casing diameter 2 in. Was casing pulled? Yes [x] No [] If yes, how much 30'
Casing height above or below land surface 30 in.

6 GROUT PLUG MATERIAL: [] Neat cement [] Cement grout [x] Bentonite [] Other _____
Grout Plug Intervals: From 30 ft. to 2 ft., From _____ ft. to _____ ft., From _____ to _____ ft.
What is the nearest source of possible contamination:
[] Septic tank [] Seepage pit [] Fuel Storage [x] Other (specify below)
[] Sewer lines [] Pit privy [] Fertilizer storage Rallyard
[] Watertight sewer lines [] Sewage lagoon [] Insecticide storage
[] Lateral lines [] Feedyard [] Abandoned water well Direction from well? _____
[] Cess pool [] Livestock pens [] Oil well/Gas well How many feet? _____

FROM	TO	PLUGGING MATERIALS	FROM	TO	PLUGGING MATERIALS
30	2	Bentonite			
2	0	Topsoil			

7 CONTRACTOR'S OR LANDOWNER'S CERTIFICATION: This water well was plugged under my jurisdiction and was completed on (mo/day/year) 9-13-11 and this record is true to the best of my knowledge and belief. Kansas Water Well Contractor's License No. 710. This Water Well Record was completed on (mo/day/year) 10/03/11 under the business name of Below Ground Surface, Inc. by (signature) []

INSTRUCTIONS: Use typewriter or ballpoint pen. Please press firmly and print clearly. Please fill in blanks, underline or circle the correct answers. Send top three copies to Kansas Department of Health and Environment, Bureau of Water, Geology Section, 1000 SW Jackson St., Ste. 420, Topeka, Kansas 66612-1367. Telephone: 785/296-5524. Send one to Water Well Owner and retain one for your records. Visit us at http://www.kdheks.gov/waterwell/index.html.

Check one: [] White Copy [] Blue Copy [] Pink Copy