

**WATER WELL PLUGGING RECORD Form WWC-5P**

KSA 82a-1212 ID NO.


MW-04

<b>1 LOCATION OF WATER WELL:</b> County: Sumner	Fraction ¼ SE ¼ SE ¼ SE ¼	Section Number 18	Township Number T 32 S	Range Number 1 <input checked="" type="checkbox"/> E <input type="checkbox"/> W
--	------------------------------	----------------------	---------------------------	--

Street/Rural Address of Well Location; if unknown, distance & direction from nearest town or intersection: If at owner's address, check here  **766 E. 20th St. S  
Wellington KS 67152**

**Global Positioning Systems (GPS) information:**  
Latitude: 37.263075 (in decimal degrees)  
Longitude: -97.354406 (in decimal degrees)  
Elevation:  
Horizontal Datum:  WGS84,  NAD83,  NAD27  
Collection Method:

<b>2 WATER WELL OWNER:</b> Wolcott and Lincoln RR#, St. Address, Box #: 4800 Main St., Ste. 565 City, State ZIP Code: Kansas City MO 64112	<input checked="" type="checkbox"/> GPS unit (Make/Model: <u>Garmin etrek</u> ) <input type="checkbox"/> Digital Map/Photo, <input type="checkbox"/> Topographic Map, <input type="checkbox"/> Land Survey Est. Accuracy: <input type="checkbox"/> < 3 m, <input checked="" type="checkbox"/> 3-5 m, <input type="checkbox"/> 5-15 m, <input type="checkbox"/> > 15 m
--	---

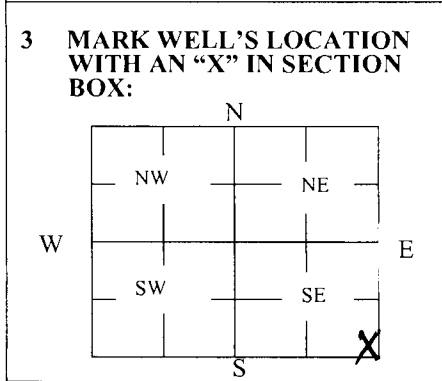

**4 DEPTH OF WELL** 27 ft.  
WELL'S STATIC WATER LEVEL 19 ft.  
WELL WAS USED AS:

<input type="checkbox"/> Domestic	<input type="checkbox"/> Public Water Supply	<input type="checkbox"/> Dewatering
<input type="checkbox"/> Irrigation	<input type="checkbox"/> Oil Field Water Supply	<input checked="" type="checkbox"/> Monitoring
<input type="checkbox"/> Feedlot	<input type="checkbox"/> Domestic (Lawn & Garden)	<input type="checkbox"/> Injection Well
<input type="checkbox"/> Industrial	<input type="checkbox"/> Air Conditioning	<input type="checkbox"/> Other _____

Was a chemical/bacteriological sample submitted to Department? Yes  No

**5 TYPE OF BLANK CASING USED:**

<input checked="" type="checkbox"/> Steel	<input type="checkbox"/> RMP (SR)	<input type="checkbox"/> Wrought	<input type="checkbox"/> Fiberglass	<input type="checkbox"/> Other (Specify below)
<input checked="" type="checkbox"/> PVC	<input type="checkbox"/> ABS	<input type="checkbox"/> Asbestos-Cement	<input type="checkbox"/> Concrete Tile	

Blank casing diameter 2 in. Was casing pulled? Yes  No  If yes, how much all  
Casing height above or below land surface -6 in.

**6 GROUT PLUG MATERIAL:**  Neat cement  Cement grout  Bentonite  Other Top Soil

Grout Plug Intervals: From 0 ft. to 3 ft., From 3 ft. to 27 ft., From — ft. to — ft.

What is the nearest source of possible contamination:

<input type="checkbox"/> Septic tank	<input type="checkbox"/> Seepage pit	<input type="checkbox"/> Fuel storage	<input type="checkbox"/> Other (specify below)
<input type="checkbox"/> Sewer lines	<input type="checkbox"/> Pit privy	<input type="checkbox"/> Fertilizer storage	<u>unknown</u>
<input type="checkbox"/> Watertight sewer lines	<input type="checkbox"/> Sewage lagoon	<input type="checkbox"/> Insecticide storage	
<input type="checkbox"/> Lateral lines	<input type="checkbox"/> Feedyard	<input type="checkbox"/> Abandoned water well	Direction from well? <u>unknown</u>
<input type="checkbox"/> Cess pool	<input type="checkbox"/> Livestock pens	<input type="checkbox"/> Oil well/Gas well	How many feet? <u>unknown</u>

FROM	TO	PLUGGING MATERIALS	FROM	TO	PLUGGING MATERIALS
0	3	Top Soil			
3	27	Bentonite			

**7 CONTRACTOR'S OR LANDOWNER'S CERTIFICATION:** This water well was plugged under my jurisdiction and was completed on (mo/day/year) 10/11/2018 and this record is true to the best of my knowledge and belief. Kansas Water Well Contractor's License No. 710. This Water Well Record was completed on (mo/day/year) 10/12/2018 under the business name of Below Ground Surface, Inc. by (signature) Craig R. H...

Send one white copy to Kansas Department of Health & Environment, Geology Section, 1000 SW Jackson Street, Ste. 420, Topeka, KS 66612-1367. Send one copy to WATER WELL OWNER and retain one for your records.  
Visit us at <http://www.kdhcks.gov/waterwell/index.html> Telephone 785-296-5524.


Summer

NW NW NW  
SE SE SE

20-2a-1  
18-32-1

**LEGEND**

- Monitor Well
- Plugged Monitor Well



0 400 800  
Feet

APTIM  
2872 NORTH RIDGE ROAD, SUITE 1028  
WICHITA, KANSAS 67205  
(316) 220-8070

**SITE MAP**

CLIENT: WOLCOTT & LINCOLN  
WELLINGTON, LLC

LOCATION: WELLINGTON, KANSAS

FIGURE: 1



© 2018 APTIM. All rights reserved. This document is the property of APTIM and is not to be distributed, copied, or reproduced without the written consent of APTIM.