

**WATER WELL PLUGGING RECORD Form WWC-5P**

KSA 82a-1212

ID NO.

MW- 9

**1 LOCATION OF WATER WELL:** Fraction ¼ SE ¼ SE ¼ SE ¼ Section Number 18 Township Number T 32 S Range Number 1  E  W  
 County: Sumner

Street/Rural Address of Well Location; if unknown, distance & direction from nearest town or intersection: If at owner's address, check here  766 E 20<sup>th</sup> St. S

Wellington KS 67152


**Global Positioning Systems (GPS) information:**

Latitude: 37.262059 (in decimal degrees)  
 Longitude: -97.355319 (in decimal degrees)  
 Elevation: \_\_\_\_\_  
 Horizontal Datum:  WGS84,  NAD83,  NAD27  
 Collection Method: \_\_\_\_\_

**2 WATER WELL OWNER:** Wolcott and Lincoln  
 RR#, St. Address, Box #: 4800 Main St., Ste. 565  
 City, State ZIP Code: Kansas City MO 64112

GPS unit (Make/Model: Garmin etrek)  
 Digital Map/Photo,  Topographic Map,  Land Survey  
 Est. Accuracy:  < 3 m,  3-5 m,  5-15 m,  > 15 m

**3 MARK WELL'S LOCATION WITH AN "X" IN SECTION BOX:**

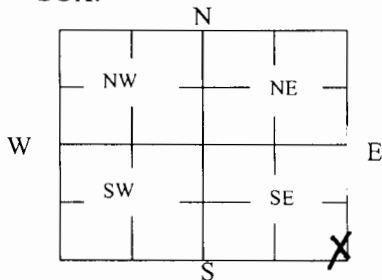

**4 DEPTH OF WELL** 26 ft.

WELL'S STATIC WATER LEVEL 23 ft

WELL WAS USED AS:

- Domestic
- Irrigation
- Feedlot
- Industrial
- Public Water Supply
- Oil Field Water Supply
- Domestic (Lawn & Garden)
- Air Conditioning
- Dewatering
- Monitoring
- Injection Well
- Other \_\_\_\_\_

Was a chemical/bacteriological sample submitted to Department? Yes  No

**5 TYPE OF BLANK CASING USED:**

- Steel
- RMP (SR)
- Wrought
- Fiberglass
- Other (Specify below) \_\_\_\_\_
- PVC
- ABS
- Asbestos-Cement
- Concrete Tile

Blank casing diameter 2 in. Was casing pulled? Yes  No  If yes, how much all  
 Casing height above or below land surface 30 in.

**6 GROUT PLUG MATERIAL:**  Neat cement  Cement grout  Bentonite  Other Top Soil

Grout Plug Intervals: From 0 ft. to 3 ft., From 3 ft. to 26 ft., From — ft. to — ft.

What is the nearest source of possible contamination:

- Septic tank
  - Sewer lines
  - Watertight sewer lines
  - Lateral lines
  - Cess pool
  - Seepage pit
  - Pit privy
  - Sewage lagoon
  - Feedyard
  - Livestock pens
  - Fuel storage
  - Fertilizer storage
  - Insecticide storage
  - Abandoned water well
  - Oil well/Gas well
  - Other (specify below) unknown
- Direction from well? unknown  
 How many feet? unknown

FROM	TO	PLUGGING MATERIALS	FROM	TO	PLUGGING MATERIALS
0	3	Top Soil			
3	<u>26</u>	Bentonite			

**7 CONTRACTOR'S OR LANDOWNER'S CERTIFICATION:** This water well was plugged under my jurisdiction and was completed on (mo/day/year) 10/11/2018 and this record is true to the best of my knowledge and belief. Kansas Water Well Contractor's License No. 710. This Water Well Record was completed on (mo/day/year) 10/12/2018 under the business name of Below Ground Surface, Inc. by (signature) [Signature]

Send one white copy to Kansas Department of Health & Environment, Geology Section, 1000 SW Jackson Street, Ste. 420, Topeka, KS 66612-1367. Send one copy to WATER WELL OWNER and retain one for your records.  
 Visit us at <http://www.kdheks.gov/waterwell/index.html> Telephone 785-296-5524.

Summer


NW NW NW  
SE SE SE

20-22-1  
18-32-1



**LEGEND**

-  Monitor Well
-  Plugged Monitor Well

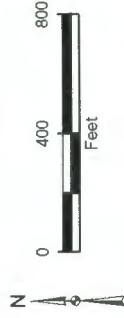

2872 NORTH RIDGE ROAD, SUITE 1028  
WICHITA, KANSAS 67205  
(316) 220-8070

**SITE MAP**

CLIENT: WOLCOTT & LINCOLN  
WELLINGTON, LLC

LOCATION: WELLINGTON, KANSAS

FIGURE: 1