


1 LOCATION OF WATER WELL: County: Chautauqua Fraction: South 1/2 Sect SE 1/4 NW 1/4 NE 1/4 Section Number: 17 Township Number: T 32 S Range Number: R 11 EW

Distance and direction from nearest town or city street address of well if located within city?
11 miles North Sedan, KS

2 WATER WELL OWNER: John Kready
RR#, St. Address, Box #: 14301 Syndance
City, State, ZIP Code: Wichita, KS 67230
Board of Agriculture, Division of Water Resources
Application Number: NA

3 LOCATE WELL'S LOCATION WITH AN "X" IN SECTION BOX:

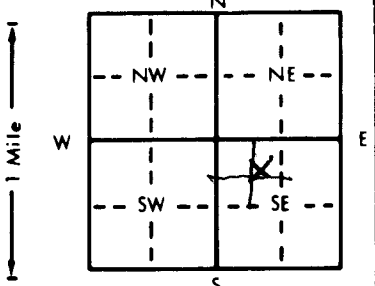

4 DEPTH OF COMPLETED WELL: 140 ft. ELEVATION: _____ ft.
Depth(s) Groundwater Encountered: 1. _____ ft. 2. _____ ft. 3. _____ ft.
WELL'S STATIC WATER LEVEL: 60 ft. below land surface measured on mo/day/yr JUNE 1
Pump test data: Well water was _____ ft. after _____ hours pumping _____ gpm
Est. Yield 2 gpm: Well water was _____ ft. after _____ hours pumping _____ gpm
Bore Hole Diameter: 14 in. to 140 ft., and _____ in. to _____ ft.
WELL WATER TO BE USED AS:
 1 Domestic 3 Feedlot 6 Oil field water supply 9 Dewatering 12 Other (Specify below)
 2 Irrigation 4 Industrial 7 Lawn and garden only 10 Monitoring well
Was a chemical/bacteriological sample submitted to Department? Yes _____ No If yes, mo/day/yr sample was submitted _____
Water Well Disinfected? Yes No _____

5 TYPE OF BLANK CASING USED:
1 Steel 3 RMP (SR) 5 Wrought iron 8 Concrete tile CASING JOINTS: Glued Clamped _____
 2 PVC 4 ABS 7 Fiberglass _____ Welded _____
Blank casing diameter: 10 in. to _____ ft., Dia. _____ in. to _____ ft., Dia. _____ in. to _____ ft.
Casing height above land surface: 18 in., weight _____ lbs./ft. Wall thickness or gauge No. 160

TYPE OF SCREEN OR PERFORATION MATERIAL:
1 Steel 3 Stainless steel 5 Fiberglass 8 RMP (SR) 11 Other (specify) _____
2 Brass 4 Galvanized steel 6 Concrete tile 9 ABS 12 None used (open hole) _____
SCREEN OR PERFORATION OPENINGS ARE:
1 Continuous slot 3 Mill slot 5 Gauzed wrapped 8 Saw cut 11 None (open hole)
2 Louvered shutter 4 Key punched 6 Wire wrapped 9 Drilled holes _____
3 Torch cut 10 Other (specify) _____

SCREEN-PERFORATED INTERVALS: From 140 ft. to 120 ft., From 80 ft. to 60 ft.
From _____ ft. to _____ ft., From _____ ft. to _____ ft.
GRAVEL PACK INTERVALS: From 140 ft. to 25 ft., From _____ ft. to _____ ft.
From _____ ft. to _____ ft., From _____ ft. to _____ ft.

6 GROUT MATERIAL: 1 Neat cement 2 Cement grout 3 Bentonite 4 Other _____
Grout intervals: From 0 ft. to 25 ft., From _____ ft. to _____ ft., From _____ ft. to _____ ft.
What is the nearest source of possible contamination:
 1 Septic tank 4 Lateral lines 7 Pit privy 10 Livestock pens 14 Abandoned water well
 2 Sewer lines 5 Cess pool 8 Sewage lagoon 11 Fuel storage 15 Oil well/Gas well
 3 Watertight sewer lines 6 Seepage pit 9 Feedyard 12 Fertilizer storage 16 Other (specify below) _____
 13 Insecticide storage _____
How many feet? 150

FROM		TO		LITHOLOGIC LOG	FROM	TO	PLUGGING INTERVALS
0	5	5	20	Soil			
5	20	20	25	sand pit & clay			
20	25	25	50	lin s			
25	50	50	58	shale			
50	58	58	65	lin s			
58	65	65	85	sand (water)			
65	85	85	100	shale			
85	100	100	115	lin s			
100	115	115	125	shale			
115	125	125	140	shale			

7 CONTRACTOR'S OR LANDOWNER'S CERTIFICATION: This water well was constructed, (2) reconstructed, or (3) plugged under my jurisdiction and was completed on (mo/day/year) 6-1-96 and this record is true to the best of my knowledge and belief. Kansas Water Well Contractor's License No. 512 This Water Well Record was completed on (mo/day/yr) 6-18-96 under the business name of _____ by (signature) John Bready

INSTRUCTIONS: Use typewriter or ball point pen. PLEASE PRESS FIRMLY and PRINT clearly. Please fill in blanks, underline or circle the correct answers. Send top three copies to Kansas Department of Health and Environment, Bureau of Water, Topeka, Kansas 66620-0001. Telephone: 913-296-5545. Send one to WATER WELL OWNER and retain one for your records.

OFFICE USE ONLY
T
R
EW
SEC.
1/4
1/4
1/4