


1 LOCATION OF WATER WELL: County: <u>MONTGOMERY</u>	Fraction <u>N SW Cor. NW ¹/₄</u>	Section Number <u>25</u>	Township Number <u>32</u>	Range Number <u>14</u> <input checked="" type="radio"/> EW
--	---	-----------------------------	------------------------------	---

Distance and direction from nearest town or city street address of well if located within city?
7 miles of Independence to CR 2500, thence north 3/4 mile thence east/southeast 1/4 mile down PRIVATE DRIVE (4476 CR 2500, Ind.)

2 WATER WELL OWNER: <u>BETH ERBE ESTATE</u> RR#, St. Address, Box #: <u>4476-A CR 2500</u> City, State ZIP Code: <u>INDEPENDENCE, KANSAS 67301</u>	Global Positioning Systems (decimal degrees, min. of 4 digits) Latitude: _____ Longitude: _____ Elevation: _____ Datum: _____ Data Collection Method: _____
--	--

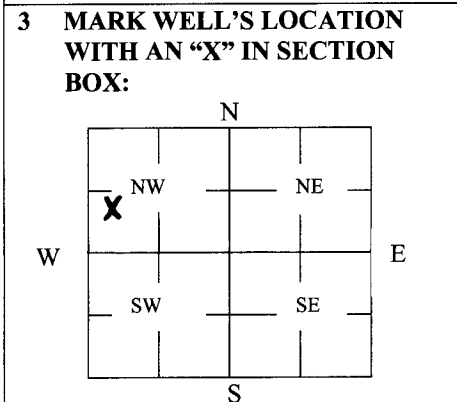

4 DEPTH OF WELL 35 ft.
 WELL'S STATIC WATER LEVEL 4 1/2 ft.
 WELL WAS USED AS:

1 Domestic	5 Public Water Supply	9 Dewatering
2 Irrigation	6 Oil Field Water Supply	10 Monitoring
3 Feedlot	7 Domestic (Lawn & Garden)	11 Injection Well
4 Industrial	8 Air Conditioning	12 Other <u>UNKNOWN</u>

Was a chemical/bacteriological sample submitted to Department? Yes _____ No

5 TYPE OF BLANK CASING USED:

1 Steel	3 RMP (SR)	5 Wrought	7 Fiberglass	9 Other (Specify below)
2 PVC	4 ABS	6 Asbestos-Cement	8 Concrete Tile	<u>HAND DUG</u>

Blank casing diameter _____ in. Was casing pulled? Yes _____ No _____ If yes, how much _____
 Casing height above or below land surface _____ in.

6 GROUT PLUG MATERIAL: 1 Neat cement 2 Cement grout 3 Bentonite 4 Other _____

Grout Plug Intervals: From 5 ft. to 4 ft., From _____ ft. to _____ ft., From _____ to _____ ft.

What is the nearest source of possible contamination:

1 Septic tank	6 Seepage pit	11 Fuel Storage	16 Other (specify below)
2 Sewer lines	7 Pit privy	12 Fertilizer storage	_____
3 Watertight sewer lines	<input checked="" type="radio"/> 8 Sewage lagoon	13 Insecticide storage	_____
4 Lateral lines	9 Feedyard	14 Abandoned water well	Direction from well? <u>EAST</u>
5 Cess pool	10 Livestock pens	15 Oil well/Gas well	How many feet? <u>10</u>

FROM	TO	PLUGGING MATERIALS	FROM	TO	PLUGGING MATERIALS
<u>35'</u>	<u>5'</u>	<u>Chlorinated GRAVEL</u>			
<u>5'</u>	<u>4'</u>	<u>NEAT CEMENT</u>			
<u>4'</u>	<u>GRADE</u>	<u>EARTHEN COVER</u>			

7 CONTRACTOR'S OR LANDOWNER'S CERTIFICATION: This water well was plugged under my jurisdiction and was completed on (mo/day/year) 02/13/2014 and this record is true to the best of my knowledge and belief. Kansas Water Well Contractor's License No. _____ This Water Well Record was completed on (mo/day/year) 02/18/2014 under the business name of O'Brien Const. by (signature) James O'Brien

INSTRUCTIONS: Use typewriter or ballpoint pen. Please press firmly and print clearly. Please fill in blanks, underline or circle the correct answers. Send top three copies to Kansas Department of Health and Environment, Bureau of Water, Geology Section, 1000 SW Jackson St., Ste. 420, Topeka, Kansas 66612-1367. Telephone: 785/296-5522. Send one to Water Well Owner and retain one for your records. Visit us at <http://www.kdheks.gov/geo/waterwells>.