


mw-2

1 LOCATION OF WATER WELL: County: **Montgomery** Fraction: **NE** **NE** **NE** Section Number: **35** Township Number: **32** Range Number: **15** **EW**

Distance and direction from nearest town or city street address of well if located within city?
100 N. 25th Street, Independence, KS

2 WATER WELL OWNER: **Conoco Food Store Attn: H.F. Johnson**
1020 W. Sycamore, Independence, Kansas
 Board of Agriculture, Division of Water Resources
 Application Number: **-----**

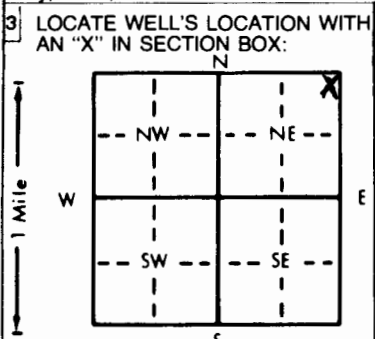

4 DEPTH OF COMPLETED WELL: **9** ft. ELEVATION: **-----**
 Depth(s) Groundwater Encountered 1. **4.5** ft. 2. **-----** ft. 3. **-----** ft.
 WELL'S STATIC WATER LEVEL: **3.91** ft. below land surface measured on mo/day/yr **8-11-97**
 Pump test data: Well water was **-----** ft. after **-----** hours pumping **-----** gpm
 Est. Yield **-----** gpm: Well water was **-----** ft. after **-----** hours pumping **-----** gpm
 Bore Hole Diameter: **8.625** in. to **-----** in. to **-----** in.
 WELL WATER TO BE USED AS:
 1 Domestic 3 Feedlot 6 Oil field water supply 9 Dewatering 12 Other (Specify below)
 2 Irrigation 4 Industrial 7 Lawn and garden only 10 Monitoring well **mw-2**
 Was a chemical/bacteriological sample submitted to Department? Yes **-----** No **X**; If yes, mo/day/yr sample was submitted **-----**
 Water Well Disinfected? Yes **-----** No **X**

5 TYPE OF BLANK CASING USED:
 1 Steel 3 RMP (SR) 5 Wrought iron 8 Concrete tile CASING JOINTS: Glued **-----** Clamped **-----**
 2 PVC 4 ABS 6 Asbestos-Cement 9 Other (specify below) Welded **-----**
 7 Fiberglass **-----** Threaded **X**
 Blank casing diameter **2** in. to **3** ft., Dia. **-----** in. to **-----** ft., Dia. **-----** in. to **-----** ft.
 Casing height above land surface **0** in., weight **SCH. 40 PVC** lbs./ft. Wall thickness or gauge No. **-----**
 TYPE OF SCREEN OR PERFORATION MATERIAL:
 1 Steel 3 Stainless steel 5 Fiberglass 8 RMP (SR) 10 Asbestos-cement
 2 Brass 4 Galvanized steel 6 Concrete tile 9 ABS 11 Other (specify) **-----**
 12 None used (open hole)
 SCREEN OR PERFORATION OPENINGS ARE:
 1 Continuous slot 3 Mill slot 5 Gauzed wrapped 8 Saw cut 11 None (open hole)
 2 Louvered shutter 4 Key punched 6 Wire wrapped 9 Drilled holes
 7 Torch cut 10 Other (specify) **-----**
 SCREEN-PERFORATED INTERVALS: From **3** ft. to **9** ft. From **-----** ft. to **-----** ft.
SAND GRAVEL PACK INTERVALS: From **2** ft. to **9** ft. From **-----** ft. to **-----** ft.

6 GROUT MATERIAL: **20** 1 Neat cement 2 Cement grout 3 Bentonite 4 Other **-----**
 Grout Intervals: From **0** ft. to **1** ft. From **1** ft. to **2** ft. From **-----** ft. to **-----** ft.
 What is the nearest source of possible contamination:
 1 Septic tank 4 Lateral lines 7 Pit privy 10 Livestock pens 14 Abandoned water well
 2 Sewer lines 5 Cess pool 8 Sewage lagoon 11 Fuel storage 15 Oil well/Gas well
 3 Watertight sewer lines 6 Seepage pit 9 Feedyard 12 Fertilizer storage 16 Other (specify below) **cont. site**
 13 Insecticide storage
 Direction from well? **-----** How many feet? **-----**

FROM	TO	LITHOLOGIC LOG	FROM	TO	PLUGGING INTERVALS
GL	1.00	Concrete			
1.00	5.50	Silty Clay (CL)			
5.50	8.50	Shale			
8.50	9.00	Limestone			
9.00	TD	End of Borehole			

7 CONTRACTOR'S OR LANDOWNER'S CERTIFICATION: This water well was **constructed** (2) reconstructed, or (3) plugged under my jurisdiction and was completed on (mo/day/year) **6-26-97** and this record is true to the best of my knowledge and belief. Kansas Water Well Contractor's License No. **585** This Water Well Record was completed on (mo/day/yr) **8-12-97** under the business name of **AEI** by (signature) **H. Johnson for P. Duncan**

OFFICE USE ONLY
T
R
EW
SEC.