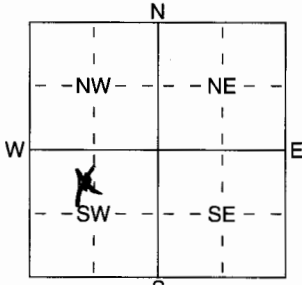


1 LOCATION OF WATER WELL: Fraction NW 1/4 SW 1/4 - 1/4 Section Number 25 Township Number T 32 S Range Number R 13 EDW
 County: Montgomery
 Distance and direction from nearest town or city street address of well if located within city? 800 N 21st

2 WATER WELL OWNER: Earth Care Products
 RR#, St. Address, Box # : 800 N 21st Board of Agriculture, Division of Water Resources
 City, State, ZIP Code : Independence, KS 67301 Application Number:

3 LOCATE WELL'S LOCATION WITH AN "X" IN SECTION BOX:

 4 DEPTH OF COMPLETED WELL 38 ft. ELEVATION:
 Depth(s) Groundwater Encountered: 1 29 ft. 2 ft. 3 4-15-05 ft.
 WELL'S STATIC WATER LEVEL 10.01 ft. below land surface measured on mo/day/yr 4-15-05
 Pump test data: Well water was ft. after hours pumping gpm
 Est. Yield gpm: Well water was NA ft. after hours pumping gpm
 WELL WATER TO BE USED AS: 5 Public water supply 8 Air conditioning 11 Injection well
 1 Domestic 3 Feedlot 6 Oil field water supply 9 Dewatering 12 Other (Specify below)
 2 Irrigation 4 Industrial 7 Domestic (lawn & garden) 10 Monitoring well MWISD
 Was a chemical/bacteriological sample submitted to Department? Yes No X If yes, mo/day/yr sample was submitted
 Water Well Disinfected? Yes NA

5 TYPE OF BLANK CASING USED:
 1 Steel 3 RMP (SR) 5 Wrought iron 8 Concrete tile CASING JOINTS: Glued Clamped
 2 PVC 4 ABS 6 Asbestos-Cement 9 Other (specify below) Welded
 7 Fiberglass Threaded 7
 Blank casing diameter 2 in. to 28 ft., Dia in. to ft., Dia in. to ft.
 Casing height above land surface 30 in., weight lbs./ft. Wall thickness or gauge No. 3/4 40
 TYPE OF SCREEN OR PERFORATION MATERIAL:
 1 Steel 3 Stainless Steel 5 Fiberglass 8 RMP (SR) 10 Asbestos-Cement
 2 Brass 4 Galvanized Steel 6 Concrete tile 9 ABS 11 Other (Specify)
 12 None used (open hole)
 SCREEN OR PERFORATION OPENINGS ARE:
 1 Continuous slot 3 Mill slot 5 Gauzed wrapped 8 Saw cut 11 None (open hole)
 2 Louvered shutter 4 Key punched 6 Wire wrapped 9 Drilled holes
 7 Torch cut 10 Other (specify) ft.
 SCREEN-PERFORATED INTERVALS: From 38 ft. to 28 ft., From ft. to ft.
 GRAVEL PACK INTERVALS: From 38 ft. to 25 ft., From ft. to ft.

6 GROUT MATERIAL: 1 Neat cement 2 Cement grout 3 Bentonite 4 Other
 Grout Intervals: From 25 ft. to 3 ft., From ft. to ft., From ft. to ft.
 What is the nearest source of possible contamination:
 1 Septic tank 4 Lateral lines 7 Pit privy 10 Livestock pens 14 Abandoned water well
 2 Sewer lines 5 Cess pool 8 Sewage lagoon 11 Fuel storage 15 Oil well/Gas well
 3 Watertight sewer lines 6 Seepage pit 9 Feedyard 12 Fertilizer storage 16 Other (specify below)
 13 Insecticide storage near MW-16
 Direction from well? NE How many feet? 200

FROM	TO	LITHOLOGIC LOG	FROM	TO	PLUGGING INTERVALS
0	1	Topsoil			
1.5	5.5	silty clay			
5.5	6	silt			
6	30	interbedded shale + limestone			

7 CONTRACTOR'S OR LANDOWNER'S CERTIFICATION: This water well was (1) constructed, (2) reconstructed, or (3) plugged under my jurisdiction and was completed on (mo/day/year) 4-6-05 and this record is true to the best of my knowledge and belief. Kansas Water Well Contractor's Licence No 704 This Water Well Record was completed on (mo/day/yr) 4-15-05 under the business name of MAXS by (signature) David Newk