


1 LOCATION OF WATER WELL: Fraction NW 1/4 S 1/2 - 1/4 Section Number 25 Township Number T 32 S Range Number R 13 Q/W

Distance and direction from nearest town or city street address of well if located within city? 800 N 21st

2 WATER WELL OWNER: Earth Care Products RR#, St. Address, Box #: 800 N 21st City, State, ZIP Code: Independence KS 101 67301 Board of Agriculture, Division of Water Resources Application Number:

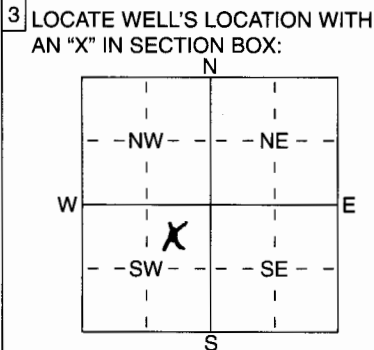

3 LOCATE WELL'S LOCATION WITH AN 'X' IN SECTION BOX: 4 DEPTH OF COMPLETED WELL 23.4 ft. ELEVATION: 2.95 ft. below land surface measured on mo/day/yr 4-15-05

5 TYPE OF BLANK CASING USED: 1 Steel, 2 PVC, 3 RMP (SR), 4 ABS, 5 Wrought iron, 6 Asbestos-Cement, 7 Fiberglass, 8 Concrete tile, 9 Other (specify below), CASING JOINTS: Glued, Clamped, Welded, Threaded

6 GROUT MATERIAL: 1 Neat cement, 2 Cement grout, 3 Bentonite, 4 Other, Grout Intervals: From 1 ft. to 3 ft., From 5 ft. to 10 ft., From 4 ft. to 10 ft.

Table with columns: FROM, TO, LITHOLOGIC LOG, FROM, TO, PLUGGING INTERVALS. Contains handwritten entries for silty clay, sandy silt, and silty clay.

7 CONTRACTOR'S OR LANDOWNER'S CERTIFICATION: This water well was (1) constructed, (2) reconstructed, or (3) plugged under my jurisdiction and was completed on (mo/day/year) 4-7-05 and this record is true to the best of my knowledge and belief. Kansas Water Well Contractor's Licence No 704 This Water Well Record was completed on (mo/day/yr) 4-13-05 by (signature) David Hunsley