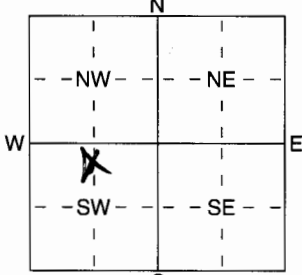


1 LOCATION OF WATER WELL: Fraction NW 1/4 S 1/2 1/4 Section Number 25 Township Number T 32 S Range Number R 15 EW  
 County: Montgomery  
 Distance and direction from nearest town or city street address of well if located within city? 800 N. 21st

2 WATER WELL OWNER: Earth Care Products  
 RR#, St. Address, Box # : 800 N 21st  
 City, State, ZIP Code : Independence, KS 67301  
 Board of Agriculture, Division of Water Resources  
 Application Number:

3 LOCATE WELL'S LOCATION WITH AN "X" IN SECTION BOX:  
  
 4 DEPTH OF COMPLETED WELL 8.5 ft. ELEVATION:  
 Depth(s) Groundwater Encountered 1 1.61 ft. 2 ..... ft. 3 ..... ft.  
 WELL'S STATIC WATER LEVEL 1.61 ft. below land surface measured on mo/day/yr 4-15-05  
 Pump test data: Well water was NA ft. after ..... hours pumping ..... gpm  
 Est. Yield ..... gpm: Well water was NA ft. after ..... hours pumping ..... gpm  
 WELL WATER TO BE USED AS: 5 Public water supply 8 Air conditioning 11 Injection well  
 1 Domestic 3 Feedlot 6 Oil field water supply 9 Dewatering 12 Other (Specify below)  
 2 Irrigation 4 Industrial 7 Domestic (lawn & garden) 10 Monitoring well MW 5  
 Was a chemical/bacteriological sample submitted to Department? Yes ..... No X; If yes, mo/day/yr sample was submitted  
 Water Well Disinfected? Yes NO

5 TYPE OF BLANK CASING USED:  
 1 Steel 3 RMP (SR) 5 Wrought iron 8 Concrete tile CASING JOINTS: Glued ..... Clamped .....  
 2 PVC 4 ABS 6 Asbestos-Cement 9 Other (specify below) Welded .....  
 7 Fiberglass Threaded X  
 Blank casing diameter 2 in. to 3.5 ft., Dia ..... in. to ..... ft., Dia ..... in. to ..... ft.  
 Casing height above land surface 21/45.6 in., weight ..... lbs./ft. Wall thickness or gauge No 2.40  
 TYPE OF SCREEN OR PERFORATION MATERIAL:  
 1 Steel 3 Stainless Steel 5 Fiberglass OPVC 8 RMP (SR) 10 Asbestos-Cement  
 2 Brass 4 Galvanized Steel 6 Concrete tile 9 ABS 11 Other (Specify) .....  
 12 None used (open hole)  
 SCREEN OR PERFORATION OPENINGS ARE:  
 1 Continuous slot 2 Louvered shutter 3 Mill slot 4 Key punched 5 Gauzed wrapped 6 Wire wrapped 7 Torch cut 8 Saw cut 9 Drilled holes 11 None (open hole) 10 Other (specify) ..... ft.  
 SCREEN-PERFORATED INTERVALS: From 8.5 ft. to 5.5 ft., From ..... ft. to ..... ft.  
 GRAVEL PACK INTERVALS: From 8.5 ft. to 4 ft., From ..... ft. to ..... ft.

6 GROUT MATERIAL: 1 Neat cement 2 Cement grout 3 Bentonite 4 Other .....  
 Grout intervals: From 4 ft. to 3 ft., From ..... ft. to ..... ft., From ..... ft. to ..... ft.  
 What is the nearest source of possible contamination:  
 1 Septic tank 4 Lateral lines 7 Pit privy 10 Livestock pens 14 Abandoned water well  
 2 Sewer lines 5 Cess pool 8 Sewage lagoon 11 Fuel storage 15 Oil well/Gas well  
 3 Watertight sewer lines 6 Seepage pit 9 Feedyard 12 Fertilizer storage 13 Insecticide storage 16 Other (specify below)  
near MW-16  
 Direction from well? SE How many feet? 325

FROM	TO	LITHOLOGIC LOG	FROM	TO	PLUGGING INTERVALS
0	0.5	Fill Wood frags Silty Clay Clayey Silt			
0.5	4.5				
4.5	8				

7 CONTRACTOR'S OR LANDOWNER'S CERTIFICATION: This water well was (1) constructed, (2) reconstructed, or (3) plugged under my jurisdiction and was completed on (mo/day/year) 4-4-05 and this record is true to the best of my knowledge and belief. Kansas Water Well Contractor's Licence No 704 This Water Well Record was completed on (mo/day/yr) 4-11-05 under the business name of Max's by (signature) David Lutz