

CORRECTION(S) TO WATER WELL RECORD (WWC-5)

(to rectify lacking or incorrect information)

Location listed as:

Section-Township-Range: 32-29S-32WFraction ($\frac{1}{4}$ $\frac{1}{4}$ $\frac{1}{4}$): SW SE SW

Location changed to:

County: Montgomery26-32S-15ESW SE SWOther changes: Initial statements: 2506 W. Main, Independence, KS 67301Changed to: 2706 W. Main, Independence, KS 67301

Comments: _____

verification method: Well owner's address, well address listed on original construction record, city street map, and mapping tool on KGS website.initials: ERJ date: 2/25/2008


submitted by: Kansas Geological Survey, Data Resources Library, 1930 Constant Ave., Lawrence, KS 66047-3726

to: Kansas Dept of Health & Environment, Bureau of Water, 1000 SW Jackson, Suite 420, Topeka, KS 66612-1367.

1 LOCATION OF WATER WELL: Montgomery County:	Fraction SW $\frac{1}{4}$ SE $\frac{1}{4}$ SW $\frac{1}{4}$	Section Number 32	Township Number 29S	Range Number 32W E/W
--	--	-----------------------------	-------------------------------	--------------------------------

Distance and direction from nearest town or city street address of well if located within city?
2506 W. Main, Independence, Ks 67301

2 WATER WELL OWNER: **Miller Brothers c/o Sam Sparks**
RR #, St. Address, Box #: **2706 W. Main** Board of Agriculture, Division of Water Resources
City, State, ZIP Code : **Independence, Ks 67301** Application Number:

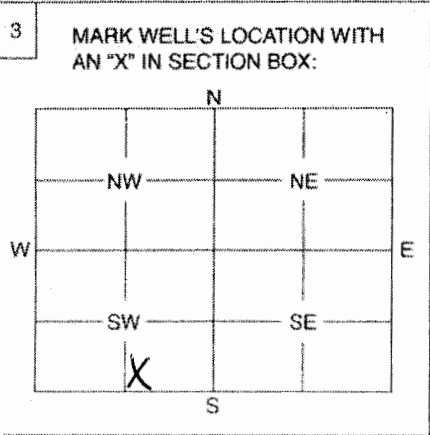

4 DEPTH OF WELL **15.05** ft.
WELL'S STATIC WATER LEVEL **4.95** ft.
WELL WAS USED AS:

1 Domestic	5 Public Water Supply	9 Dewatering
2 Irrigation	6 Oil Field Water Supply	<input checked="" type="checkbox"/> 10 Monitoring Well
3 Feedlot	7 Domestic (Lawn & Garden)	11 Injection Well
4 Industrial	8 Air Conditioning	12 Other

Was a chemical / bacteriological sample submitted to Department? Yes No **X**
If yes, mo/day/yr sample was submitted

Water Well Disinfected: Yes No **X**

5 TYPE OF BLANK CASING USED:

1 Steel	3 RMP (SR)	5 Wrought	7 Fiberglass	9 Other (Specify below)
<input checked="" type="checkbox"/> 2 PVC	4 ABS	6 Asbestos-Cement	8 Concrete Tile	

Blank casing diameter **2** in. Was casing pulled? Yes **X** No If yes, how much **3'**
Casing height above or below land surface in.

6 GROUT PLUG MATERIAL: 1 Neat cement 2 Cement grout 3 Bentonite 4 Other **cement**
 Grout Plug Intervals: From **3** **15.05** ft. to **3** ft. From **3** ft. to **0** ft. From to ft.
 What is the nearest source of possible contamination:

1 Septic tank	6 Seepage pit	11 Fuel storage
2 Sewer lines	7 Pit privy	12 Fertilizer storage
3 Watertight sewer lines	8 Sewage lagoon	13 Insecticide storage
4 Lateral lines	9 Feedyard	14 Abandoned water well
5 Cess pool	10 Livestock pens	15 Oil well/Gas well

Direction from well? How many feet?
 Other (specify below) **cont. site**

FROM	TO	PLUGGING MATERIALS
15.05	3	Bentonite
3	0	Cement

7 CONTRACTOR'S OF LANDOWNER'S CERTIFICATION: This water well was plugged under my jurisdiction and was completed on (mo/day/year) **01/29/08** and this record is true to the best of my knowledge and belief. Kansas Water Well Contractor's License No. **585** This Water Well Record was completed on (mo/day/year) **02/12/08** under the business name of **Associated Environmental, Inc.** by (signature) **B. Johnson**

INSTRUCTIONS: Use typewriter or ball point pen. Please press firmly and print clearly. Please fill in blanks, underline or circle the correct answers. Send top three copies to Kansas Department of Health and Environment, Bureau of Water, Geology Section, 1000 SW Jackson St., Ste. 420, Topeka, Kansas 66612-1367. Telephone: 785/296-5522. Send one to Water Well Owner and retain one for your records.