


WATER WELL RECORD Form WWC-5 KSA 82a-1212

1 LOCATION OF WATER WELL: Fraction SW 1/4 SE 1/4 SE 1/4 Section Number 13 Township Number T 32 S Range Number R 15 **E/W**

Distance and direction from nearest town or city street address of well if located within city?  
 ~550' W of S end of gravel rd. & 1150' S of Rajah Rd

2 WATER WELL OWNER: Magellan Pipeline Company, LP  
 RR#, St. Address, Box #: One Williams Center Board of Agriculture, Division of Water Resources  
 City, State, ZIP Code: Tulsa, OK 74172 Application Number:

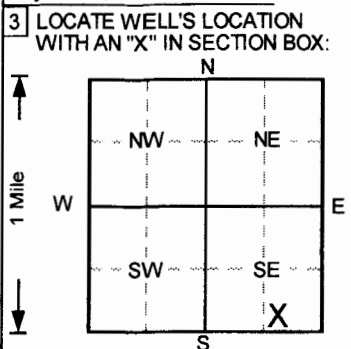

4 DEPTH OF COMPLETED WELL: 25 ft. ELEVATION: ...

Depth(s) Groundwater Encountered 1. ... ft. 2. ... ft. 3. ... ft.

WELL'S STATIC WATER LEVEL ... ft. below land surface measured on mo/day/yr ...

Pump test data: Well water was NA ft. after ... hours pumping ... gpm

Est. Yield NA gpm: Well water was ... ft. after ... hours pumping ... gpm

Bore Hole Diameter 6.25 in. to 25 ft., and ... in. to ... ft.

WELL WATER TO BE USED AS: 5 Public water supply 8 Air conditioning 11 Injection well  
 1 Domestic 3 Feedlot 6 Oil field water supply 9 Dewatering 12 Other (Specify below)  
 2 Irrigation 4 Industrial 7 Lawn and garden only **10 Monitoring well**

Was a chemical/bacteriological sample submitted to Department? Yes No  ; If yes, mo/day/yr sample was submitted

Water Well Disinfected? Yes No

5 TYPE OF BLANK CASING USED: 5 Wrought iron 8 Concrete tile CASING JOINTS: Glued Clamped  
 1 Steel 3 RMP (SR) 6 Asbestos-Cement 9 Other (specify below) Welded  
**2** PVC 4 ABS 7 Fiberglass Threaded

Blank casing diameter 2 in. to 5 ft. Dia. in. to ... ft. Dia. in. to ... ft.

Casing height above land surface 0 in., weight ... lbs./ft. Wall thickness or gauge No. Sch. 40

TYPE OF SCREEN OR PERFORATION MATERIAL **7** PVC 10 Asbestos-cement  
 1 Steel 3 Stainless steel 5 Fiberglass 8 RMP (SR) 11 Other (specify)  
 2 Brass 4 Galvanized steel 6 Concrete tile 9 ABS 12 None used (open hole)

SCREEN OR PERFORATION OPENINGS ARE: 5 Gauzed wrapped 8 Saw cut 11 None (open hole)  
 1 Continuous slot **3** Mill slot 6 Wire wrapped 9 Drilled holes  
 2 Louvered shutter 4 Key punched 7 Torch cut 10 Other (specify)

SCREEN-PERFORATED INTERVALS: From .5 ft. to 25 ft., From ... ft. to ... ft.  
 From ... ft. to ... ft., From ... ft. to ... ft.

GRAVEL PACK INTERVALS: From 4.5 ft. to 25 ft., From ... ft. to ... ft.  
 From ... ft. to ... ft., From ... ft. to ... ft.

6 GROUT MATERIAL: 1 Neat cement **2** Cement grout **3** Bentonite 4 Other

Grout Intervals: From 0.6 ft. to 1.5 ft., From 1.5 ft. to 4.5 ft., From ... ft. to ... ft.

What is the nearest source of possible contamination:  
 1 Septic tank 4 Lateral lines 7 Pit privy 10 Livestock pens 14 Abandoned water well  
 2 Sewer lines 5 Cess pool 8 Sewage lagoon 11 Fuel storage 15 Oil well/Gas well  
 3 Watertight sewer lines 6 Seepage pit 9 Feedyard 12 Fertilizer storage **16** Other (specify below)  
 13 Insecticide storage Pipeline

Direction from well? W How many feet? ~30

| FROM | TO   | LITHOLOGIC LOG                         | FROM | TO | PLUGGING INTERVALS |
|------|------|--|------|----|--------------------|
| 0    | 0.25 | Grass,                                 |      |    |                    |
| 0.25 | 6    | Silt, some sand, tr. gravel, Brown     |      |    |                    |
| 6    | 12   | Sandstone (f-vf), Mod. Yellowish Brown |      |    |                    |
| 12   | 16   | Sandstone (vf-f), Lt. Olive Gray       |      |    |                    |
| 16   | 25   | Sandstone (vf-f), Med. Lt. Gray        |      |    |                    |
|      |      |  |      |    |                    |
|      |      |  |      |    |                    |
7 CONTRACTOR'S OR LANDOWNER'S CERTIFICATION: This water well was **1** constructed, **2** reconstructed, or **3** plugged under my jurisdiction and was completed on (mo/day/year) 8/5/2008 and this record is true to the best of my knowledge and belief.

Kansas Water Well Contractor's License No. 527 This Water Well Record was completed on (mo/day/yr) 7/1/08 under the business name of GeoCore, Inc. by (signature) Dale Hall

OFFICE USE ONLY  
T  
R  
EM  
SEC.  
1/4  
1/4  
1/4