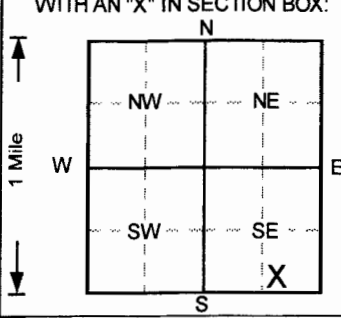


1] LOCATION OF WATER WELL: County: <b>Montgomery</b>	Fraction <b>SW ¼ SE ¼ SE ¼</b>	Section Number <b>13</b>	Township Number <b>T 32 S</b>	Range Number <b>R 15 E/W</b>
---	-----------------------------------	-----------------------------	----------------------------------	---------------------------------

Distance and direction from nearest town or city street address of well if located within city?  
 ~550'W of S end of gravel rd. & 1150'S of Rajah Rd

2] WATER WELL OWNER: **Magellan Pipeline Company, LP**  
 RR#, St. Address, Box # : **One Williams Center**  
 City, State, ZIP Code : **Tulsa, OK 74172**  
 Board of Agriculture, Division of Water Resources  
 Application Number:

3] LOCATE WELL'S LOCATION WITH AN "X" IN SECTION BOX:  


4] DEPTH OF COMPLETED WELL: **50** ft. ELEVATION: .....  
 Depth(s) Groundwater Encountered 1. .... ft. 2. .... ft. 3. .... ft.  
 WELL'S STATIC WATER LEVEL ..... ft. below land surface measured on mo/day/yr .....  
 Pump test data: Well water was **NA** ft. after ..... hours pumping ..... gpm  
 Est. Yield **NA** gpm: Well water was ..... ft. after ..... hours pumping ..... gpm  
 Bore Hole Diameter **6.25** in. to **50** ft., and ..... in. to ..... ft.  
 WELL WATER TO BE USED AS: 5 Public water supply 8 Air conditioning 11 Injection well  
 1 Domestic 3 Feedlot 6 Oil field water supply 9 Dewatering 12 Other (Specify below)  
 2 Irrigation 4 Industrial 7 Lawn and garden only **10** Monitoring well  
 Was a chemical/bacteriological sample submitted to Department? Yes.....No   
 Water Well Disinfected? Yes No

5] TYPE OF BLANK CASING USED:  
 1 Steel 3 RMP (SR) 5 Wrought iron 8 Concrete tile CASING JOINTS: Glued ..... Clamped .....  
**2** PVC 4 ABS 6 Asbestos-Cement 9 Other (specify below) Welded .....  
 7 Fiberglass ..... Threaded.   
 Blank casing diameter **2** in. to **30** ft., Dia ..... in. to ..... ft.  
 Casing height above land surface **0** in., weight ..... lbs./ft. Wall thickness or gauge No. **Sch. 40**  
 TYPE OF SCREEN OR PERFORATION MATERIAL  
 1 Steel 3 Stainless steel 5 Fiberglass **7** PVC 10 Asbestos-cement  
 2 Brass 4 Galvanized steel 6 Concrete tile 8 RMP (SR) 11 Other (specify) .....  
 12 None used (open hole)  
 SCREEN OR PERFORATION OPENINGS ARE:  
 1 Continuous slot **3** Mill slot 5 Gauzed wrapped 8 Saw cut 11 None (open hole)  
 2 Louvered shutter 4 Key punched 6 Wire wrapped 9 Drilled holes  
 7 Torch cut 10 Other (specify) .....  
 SCREEN-PERFORATED INTERVALS: From **30** ft. to **50** ft., From ..... ft. to ..... ft.  
 From ..... ft. to ..... ft., From ..... ft. to ..... ft.  
 GRAVEL PACK INTERVALS: From **27** ft. to **50** ft., From ..... ft. to ..... ft.  
 From ..... ft. to ..... ft., From ..... ft. to ..... ft.

6] GROUT MATERIAL: 1 Neat cement **2** Cement grout **3** Bentonite 4 Other .....  
 Grout Intervals: From **0.6** ft. to **1.5** ft., From **1.5** ft. to **27** ft., From ..... ft. to ..... ft.  
 What is the nearest source of possible contamination:  
 1 Septic tank 4 Lateral lines 7 Pit privy 10 Livestock pens 14 Abandoned water well  
 2 Sewer lines 5 Cess pool 8 Sewage lagoon 11 Fuel storage 15 Oil well/Gas well  
 3 Watertight sewer lines 6 Seepage pit 9 Feedyard 12 Fertilizer storage **16** Other (specify below)  
 13 Insecticide storage **Pipeline**  
 Direction from well? **W** How many feet? **~30**

FROM	TO	LITHOLOGIC LOG	FROM	TO	PLUGGING INTERVALS
0	0.25	Grass,			
0.25	6	Silt, some sand, tr. gravel, Brown			
6	12	Sandstone (f-vf), Mod. Yellowish Brown			
12	16	Sandstone (vf-f), Lt. Olive Gray			
16	26	Sandstone (vf-f), Med. Lt. Gray			
26	40	Sandstone (vf-f), Med. Lt. Gray to Med. Gray			
40	50	Shale, sandy, Lt. Gray to Med. Gray			

MW-16D

7] CONTRACTOR'S OR LANDOWNER'S CERTIFICATION: This water well was **1** constructed, (2) reconstructed, or (3) plugged under my jurisdiction and was completed on (mo/day/year) **8/5/2008** and this record is true to the best of my knowledge and belief.  
 Kansas Water Well Contractor's License No. **527** This Water Well Record was completed on (mo/day/yr) **9/1/08**  
 under the business name of **GeoCore, Inc.** by signature *Don Hall*

OFFICE USE ONLY  
T  
R  
SEC.  
¼  
¼  
¼