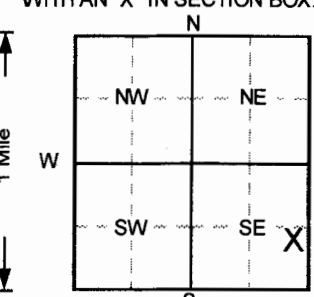


1	LOCATION OF WATER WELL: County: Montgomery	Fraction NE ¼ SE ¼ SE ¼	Section Number 13	Township Number T 32 S	Range Number R 15 (E/W)
---	--	-----------------------------------	-----------------------------	----------------------------------	--

Distance and direction from nearest town or city street address of well if located within city?

2824 Country Club Circle, Independence

2	WATER WELL OWNER: Magellan Pipeline Company, LP	RR#, St. Address, Box # : One Williams Center	Board of Agriculture, Division of Water Resources Application Number:
		City, State, ZIP Code : Tulsa, OK 74172	

3	LOCATE WELL'S LOCATION WITH AN "X" IN SECTION BOX: 	4	DEPTH OF COMPLETED WELL 40.5 ft. ELEVATION: Depth(s) Groundwater Encountered 1. ft. 2. ft. 3. ft. WELL'S STATIC WATER LEVEL ft. below land surface measured on mo/day/yr Pump test data: Well water was NA ft. after hours pumping gpm Est. Yield NA . . gpm: Well water was ft. after hours pumping gpm Bore Hole Diameter 8 . . in. to 41 . . . ft. and in. to ft. WELL WATER TO BE USED AS: 5 Public water supply 8 Air conditioning 11 Injection well 1 Domestic 3 Feedlot 6 Oil field water supply 9 Dewatering 12 Other (Specify below) 2 Irrigation 4 Industrial 7 Lawn and garden only 10 Monitoring well Soil vapor extractio . Was a chemical/bacteriological sample submitted to Department? Yes. No <input checked="" type="checkbox"/> ; If yes, mo/day/yr sample was submitted Water Well Disinfectea? Yes No <input checked="" type="checkbox"/>
---	--	---	--


5	TYPE OF BLANK CASING USED: 1 Steel 2 PVC 3 RMP (SR) 4 ABS 5 Wrought iron 6 Asbestos-Cement 7 Fiberglass 8 Concrete tile 9 Other (specify below) CASING JOINTS: Glued Clamped Welded Threaded <input checked="" type="checkbox"/>	Blank casing diameter 4 . . . in. to 30 . . . ft. Dia 4 . . . in. to 40.5 . . . ft. Dia in. to ft.
Casing height above land surface 0 . . . in., weight lbs./ft. Wall thickness or gauge No. . . . Sch. 40		
TYPE OF SCREEN OR PERFORATION MATERIAL 1 Steel 2 Brass 3 Stainless steel 4 Galvanized steel 5 Fiberglass 6 Concrete tile 7 PVC 8 RMP (SR) 9 ABS 10 Asbestos-cement 11 Other (specify) 12 None used (open hole)		
SCREEN OR PERFORATION OPENINGS ARE: 1 Continuous slot 2 Louvered shutter 3 Mill slot 4 Key punched 5 Gauzed wrapped 6 Wire wrapped 7 Torch cut 8 Saw cut 9 Drilled holes 10 Other (specify) 11 None (open hole)		
SCREEN-PERFORATED INTERVALS: From 30 . . . ft. to 40 . . . ft. From ft. to ft. From ft. to ft.		
GRAVEL PACK INTERVALS: From 29.5 . . . ft. to 41 . . . ft. From ft. to ft. From ft. to ft.		

6	GROUT MATERIAL: 1 Neat cement 2 Cement grout 3 Bentonite 4 Other Concrete	Grout Intervals: From 0 . . . ft. to 3 . . . ft. From 3 . . . ft. to 29.5 . . . ft. From ft. to ft.
---	---	---

What is the nearest source of possible contamination:

1 Septic tank	4 Lateral lines	7 Pit privy	10 Livestock pens	14 Abandoned water well
2 Sewer lines	5 Cess pool	8 Sewage lagoon	11 Fuel storage	15 Oil well/Gas well
3 Watertight sewer lines	6 Seepage pit	9 Feedyard	12 Fertilizer storage	16 Other (specify below) Pipeline
Direction from well? E			How many feet? 60	

FROM	TO	LITHOLOGIC LOG	FROM	TO	PLUGGING INTERVALS
0	0.5	Topsoil,			
0.5	4	Clay Backfill,			
4	12	Sandstone (f), well sorted, Yellowish Orange			
12	16	Silt, nonplastic, soft, tr. sandstone, Mod. Yello			
16	20	Sandstone, mod. silty, mod. plasticity, Mod. Y			
20	30	Sandstone, as above w/interbedded shale, Med			
30	41	Shale, med. hardness, reduced, Med. Gray			
SVE13D, Flushmount					

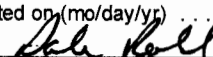7	CONTRACTOR'S OR LANDOWNER'S CERTIFICATION: This water well was (1) constructed, (2) reconstructed, or (3) plugged under my jurisdiction and was completed on (mo/day/year) 3/7/2006 and this record is true to the best of my knowledge and belief. Kansas Water Well Contractor's License No. 527 This Water Well Record was completed on (mo/day/yr) 4/24/2006 under the business name of GeoCore, Inc. by (signature) 
---	---