


1 LOCATION OF WATER WELL: Fraction **SE ¼ SE ¼ SE ¼** Section Number **13** Township Number **T 32 S** Range Number **R 15 E/W**
 County: **Montgomery**

Distance and direction from nearest town or city street address of well if located within city?

2824 Country Club Circle, Independence

2 WATER WELL OWNER: **Magellan Pipeline Company, LP**
 RR#, St. Address, Box # : **One Williams Center** Board of Agriculture, Division of Water Resources
 City, State, ZIP Code : **Tulsa, OK 74172** Application Number:

3 LOCATE WELL'S LOCATION WITH AN "X" IN SECTION BOX:

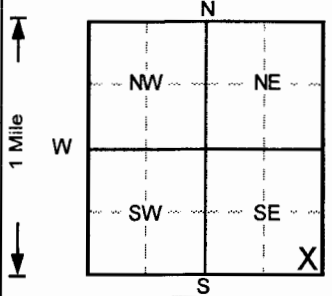

4 DEPTH OF COMPLETED WELL **25** ft. ELEVATION:

Depth(s) Groundwater Encountered 1. ft. 2. ft. 3. ft.

WELL'S STATIC WATER LEVEL ft. below land surface measured on mo/day/yr

Pump test data: Well water was . . . **NA** . . . ft. after hours pumping gpm

Est. Yield . . **NA** . . gpm: Well water was ft. after hours pumping gpm

Bore Hole Diameter . . . **8** . . . in. to **25** ft., and in. to ft.

WELL WATER TO BE USED AS: 5 Public water supply 8 Air conditioning 11 Injection well

1 Domestic 3 Feedlot 6 Oil field water supply 9 Dewatering **12 Other (Specify below)**

2 Irrigation 4 Industrial 7 Lawn and garden only 10 Monitoring well **Soil vapor extractio**

Was a chemical/bacteriological sample submitted to Department? Yes.....No ; If yes, mo/day/yr sample was submitted

Water Well Disinfected? Yes No

5 TYPE OF BLANK CASING USED: 5 Wrought iron 8 Concrete tile CASING JOINTS: Glued Clamped

1 Steel 3 RMP (SR) 6 Asbestos-Cement 9 Other (specify below) Welded

2 PVC 4 ABS 7 Fiberglass Threaded.

Blank casing diameter **4** in. to **4.5** ft., Dia **4** in. to **25** ft., Dia in. to ft.

Casing height above land surface **0** in., weight lbs./ft. Wall thickness or gauge No. **Sch. 40**

TYPE OF SCREEN OR PERFORATION MATERIAL **7** PVC 10 Asbestos-cement

1 Steel 3 Stainless steel 5 Fiberglass 8 RMP (SR) 11 Other (specify)

2 Brass 4 Galvanized steel 6 Concrete tile 9 ABS 12 None used (open hole)

SCREEN OR PERFORATION OPENINGS ARE: 5 Gauzed wrapped 8 Saw cut 11 None (open hole)

1 Continuous slot **3** Mill slot 6 Wire wrapped 9 Drilled holes

2 Louvered shutter 4 Key punched 7 Torch cut 10 Other (specify)

SCREEN-PERFORATED INTERVALS: From **4.5** ft. to **24.5** ft., From ft. to ft.

From ft. to ft., From ft. to ft.

GRAVEL PACK INTERVALS: From **4.5** ft. to **25** ft., From ft. to ft.

From ft. to ft., From ft. to ft.

6 GROUT MATERIAL: 1 Neat cement 2 Cement grout **3** Bentonite **4** Other **Concrete**

Grout Intervals: From **0** ft. to **2.5** ft., From **2.5** ft. to **4.5** ft., From ft. to ft.

What is the nearest source of possible contamination:

1 Septic tank 4 Lateral lines 7 Pit privy 10 Livestock pens 14 Abandoned water well

2 Sewer lines 5 Cess pool 8 Sewage lagoon 11 Fuel storage 15 Oil well/Gas well

3 Watertight sewer lines 6 Seepage pit 9 Feedyard 12 Fertilizer storage **16** Other (specify below)

Direction from well? **E** How many feet? **145**

FROM TO LITHOLOGIC LOG FROM TO PLUGGING INTERVALS

0 **2** **Topsoil/Clay Fill,**

2 **8** **Sandstone (f), well sorted, Yellowish Orange**

8 **16** **Sandstone, as above, well compacted,**

16 **25** **Sand, as above, interbedded with shale, Lt. Gr**

OFFICE USE ONLY

T

R

EW

SEC.

¼

¼

¼

7 CONTRACTOR'S OR LANDOWNER'S CERTIFICATION: This water well was **(1)** constructed, **(2)** reconstructed, or **(3)** plugged under my jurisdiction and was completed on (mo/day/year) **3/6/2006** and this record is true to the best of my knowledge and belief.
 Kansas Water Well Contractor's License No. **527** This Water Well Record was completed on (mo/day/yr) **4/24/2006**
 under the business name of **GeoCore, Inc.** by (signature) *Dave Bell*