


1 LOCATION OF WATER WELL: Fraction SW 1/4 SE 1/4 SE 1/4 Section Number 13 Township Number T 32 S Range Number R 15 E/W

Distance and direction from nearest town or city street address of well if located within city? 2824 Country Club Circle, Independence

2 WATER WELL OWNER: Magellan Pipeline Company, LP RR#, St. Address, Box #: One Williams Center City, State, ZIP Code: Tulsa, OK 74172 Board of Agriculture, Division of Water Resources Application Number:

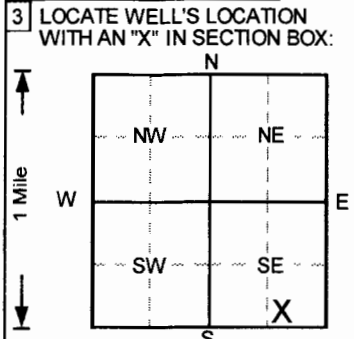

3 LOCATE WELL'S LOCATION WITH AN "X" IN SECTION BOX: 4 DEPTH OF COMPLETED WELL 40.5 ft. ELEVATION: Depth(s) Groundwater Encountered 1. ft. 2. ft. 3. ft. WELL'S STATIC WATER LEVEL ... ft. below land surface measured on mo/day/yr Pump test data: Well water was NA ft. after ... hours pumping ... gpm Est. Yield NA gpm: Well water was ... ft. after ... hours pumping ... gpm Bore Hole Diameter ... 8. in. to ... 41. ft., and ... in. to ... ft. WELL WATER TO BE USED AS: 5 Public water supply 8 Air conditioning 11 Injection well 1 Domestic 3 Feedlot 6 Oil field water supply 9 Dewatering 12 Other (Specify below) Soil vapor extractio. 2 Irrigation 4 Industrial 7 Lawn and garden only 10 Monitoring well

5 TYPE OF BLANK CASING USED: 1 Steel 3 RMP (SR) 5 Wrought iron 8 Concrete tile CASING JOINTS: Glued Clamped 2 PVC 4 ABS 6 Asbestos-Cement 9 Other (specify below) Welded 7 Fiberglass Threaded 10 Asbestos-cement 11 Other (specify) Blank casing diameter 4 in. to 30 ft. Dia 4 in. to 40.5 ft. Dia in. to ft. Casing height above land surface 0 in., weight lbs./ft. Wall thickness or gauge No. Sch. 40 TYPE OF SCREEN OR PERFORATION MATERIAL: 1 Steel 3 Stainless steel 5 Fiberglass 7 PVC 10 Asbestos-cement 2 Brass 4 Galvanized steel 6 Concrete tile 8 RMP (SR) 11 Other (specify) 12 None used (open hole) SCREEN OR PERFORATION OPENINGS ARE: 1 Continuous slot 3 Mill slot 5 Gauzed wrapped 8 Saw cut 11 None (open hole) 2 Louvered shutter 4 Key punched 6 Wire wrapped 9 Drilled holes 10 Other (specify) 7 Torch cut 12 None used (open hole) SCREEN-PERFORATED INTERVALS: From 30 ft. to 40 ft., From ... ft. to ... ft. GRAVEL PACK INTERVALS: From 29.5 ft. to 40.5 ft., From ... ft. to ... ft.

6 GROUT MATERIAL: 1 Neat cement 2 Cement grout 3 Bentonite 4 Other Concrete Grout Intervals: From 0 ft. to 3 ft., From 3 ft. to 29.5 ft., From ... ft. to ... ft. What is the nearest source of possible contamination: 1 Septic tank 4 Lateral lines 7 Pit privy 10 Livestock pens 14 Abandoned water well 2 Sewer lines 5 Cess pool 8 Sewage lagoon 11 Fuel storage 15 Oil well/Gas well 3 Watertight sewer lines 6 Seepage pit 9 Feedyard 12 Fertilizer storage 16 Other (specify below) Pipeline Direction from well? E How many feet? 200

FROM	TO	LITHOLOGIC LOG	FROM	TO	PLUGGING INTERVALS
0	2	Topsoil, Clay Fill,			
2	10	Sandstone (f), wthrd., oxidized, Yellowish Ora			
10	14	Silt, soft, nonplastic, Grayish Brown			
14	20	Silt, clayey, sl. plastic, Grayish Brown			
20	34	Shale, reduced, mod. hard, Lt. Gray			
34	41	Silt, soft, nonplastic, some interbedded, Gray			
					SVE18D , Flushmount

7 CONTRACTOR'S OR LANDOWNER'S CERTIFICATION: This water well was (1) constructed, (2) reconstructed, or (3) plugged under my jurisdiction and was completed on (mo/day/year) 3/3/2006 and this record is true to the best of my knowledge and belief. Kansas Water Well Contractor's License No. 527 This Water Well Record was completed on (mo/day/yr) 4/24/2006 under the business name of GeoCore, Inc. by (signature)